


上尾市中平塚土地区画整理事業出来形確認測量

画地原子図

平成十六年六月

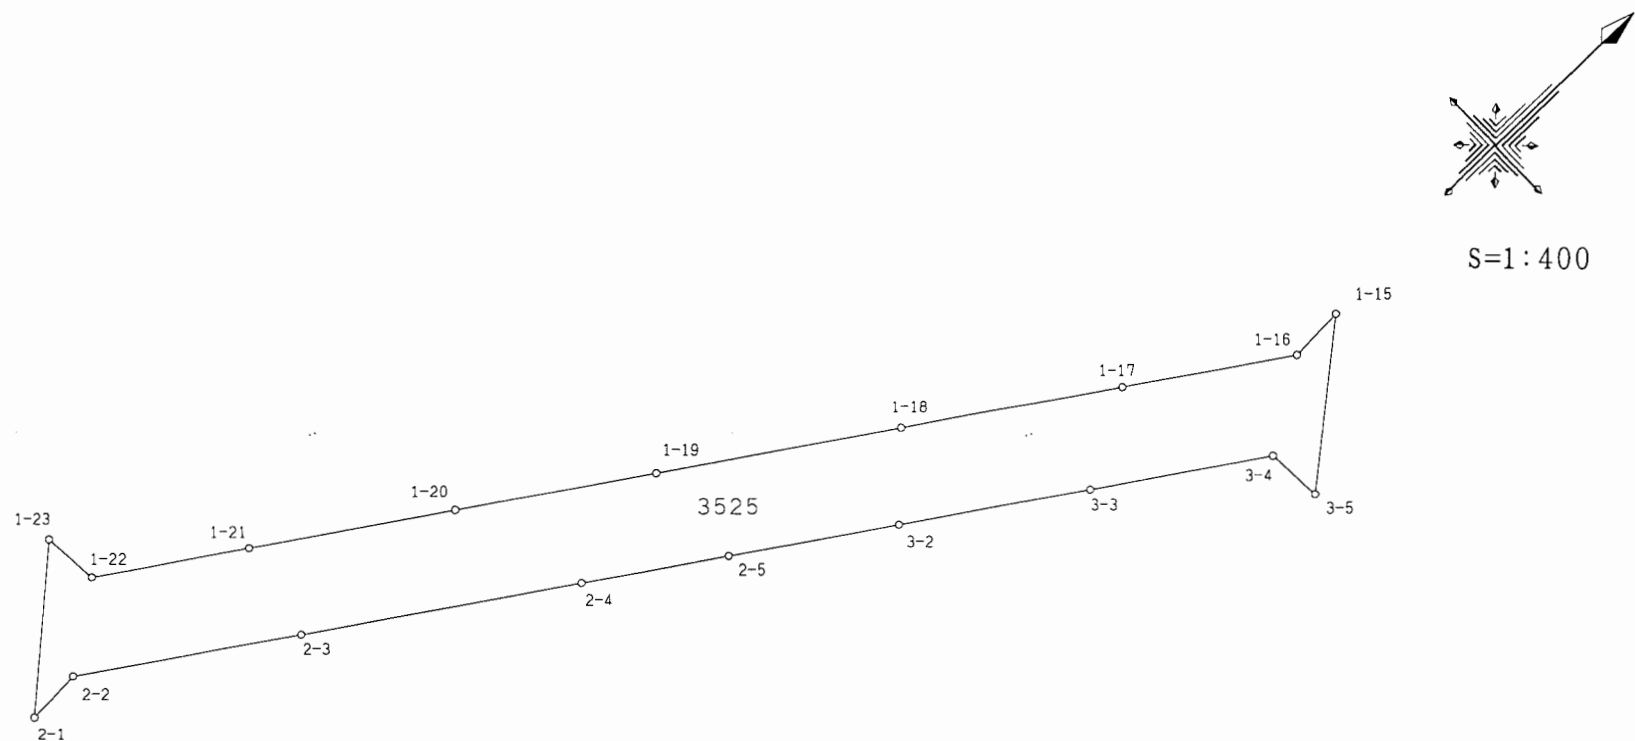

参考資料

※記載内容は換地処分当時のものです。 上尾市

画地面積計算書

現場名： 上尾市中平塚区画整理地内

画地番号： 3525

参考資料

※記載内容は換地処分当時のものです。 上尾市

点名	Xn	Yn	距離	方向角	測角	Xn+1-Xn-1	Yn+1-Yn-1	Yn*(Xn+1-Xn-1)	Xn*(Yn+1-Yn-1)
1-23	-1641.007	-20452.665	9.518	138°39'41"	52°44'09"	-7.361	3.268	150552.067065	-5362.810876
2-1	-1648.153	-20446.378	3.002	357°01'07"	38°21'26"	-4.148	6.131	84811.575944	-10104.826043
2-2	-1645.155	-20446.534	12.216	33°35'42"	216°34'35"	13.173	6.603	-269342.192382	-10862.958465
2-3	-1634.980	-20439.775	14.945	33°36'34"	180°00'52"	22.622	15.031	-462388.590050	-24575.384380
2-4	-1622.533	-20431.503	7.925	33°32'57"	179°56'23"	19.052	12.652	-389260.995156	-20528.287516
2-5	-1615.928	-20427.123	9.199	33°39'11"	180°06'14"	14.262	9.478	-291331.628226	-15315.765584
3-2	-1608.271	-20422.025	10.232	33°35'18"	179°56'07"	16.180	10.758	-330428.364500	-17301.779418
3-3	-1599.748	-20416.365	9.752	33°36'06"	180°00'48"	16.646	11.057	-339850.811790	-17688.413636
3-4	-1591.625	-20410.968	3.006	86°40'47"	233°04'41"	8.297	8.398	-169349.801496	-13366.466750
3-5	-1591.451	-20407.967	9.618	320°27'15"	53°46'28"	7.591	-3.123	-154916.877497	4970.101473
1-15	-1584.034	-20414.091	3.002	176°44'57"	36°17'42"	4.420	-5.953	-90230.282220	9429.754402
1-16	-1587.031	-20413.920	9.293	213°38'58"	216°54'01"	-10.732	-4.979	219082.189440	7901.827349
1-17	-1594.766	-20419.070	11.854	213°37'33"	179°58'35"	-17.606	-11.714	359498.146420	18681.088924
1-18	-1604.637	-20425.634	13.225	213°37'04"	179°59'31"	-20.885	-13.887	426589.366090	22283.594019
1-19	-1615.651	-20432.957	10.764	213°35'52"	179°58'48"	-19.980	-13.279	408250.480860	21454.229629
1-20	-1624.617	-20438.913	10.971	213°35'32"	179°59'40"	-18.105	-12.026	370046.519865	19537.644042
1-21	-1633.756	-20444.983	8.440	213°31'49"	179°56'17"	-16.175	-10.733	330697.600025	17535.103148
1-22	-1640.792	-20449.646	3.027	265°55'32"	232°23'43"	-7.251	-7.682	148280.383146	12604.564144

倍面積	708.785538
面積	354.3927690
地積	354.39㎡