


上尾市中平塚土地区画整理事業出来形確認測量 画地原子図

平成十六年六月

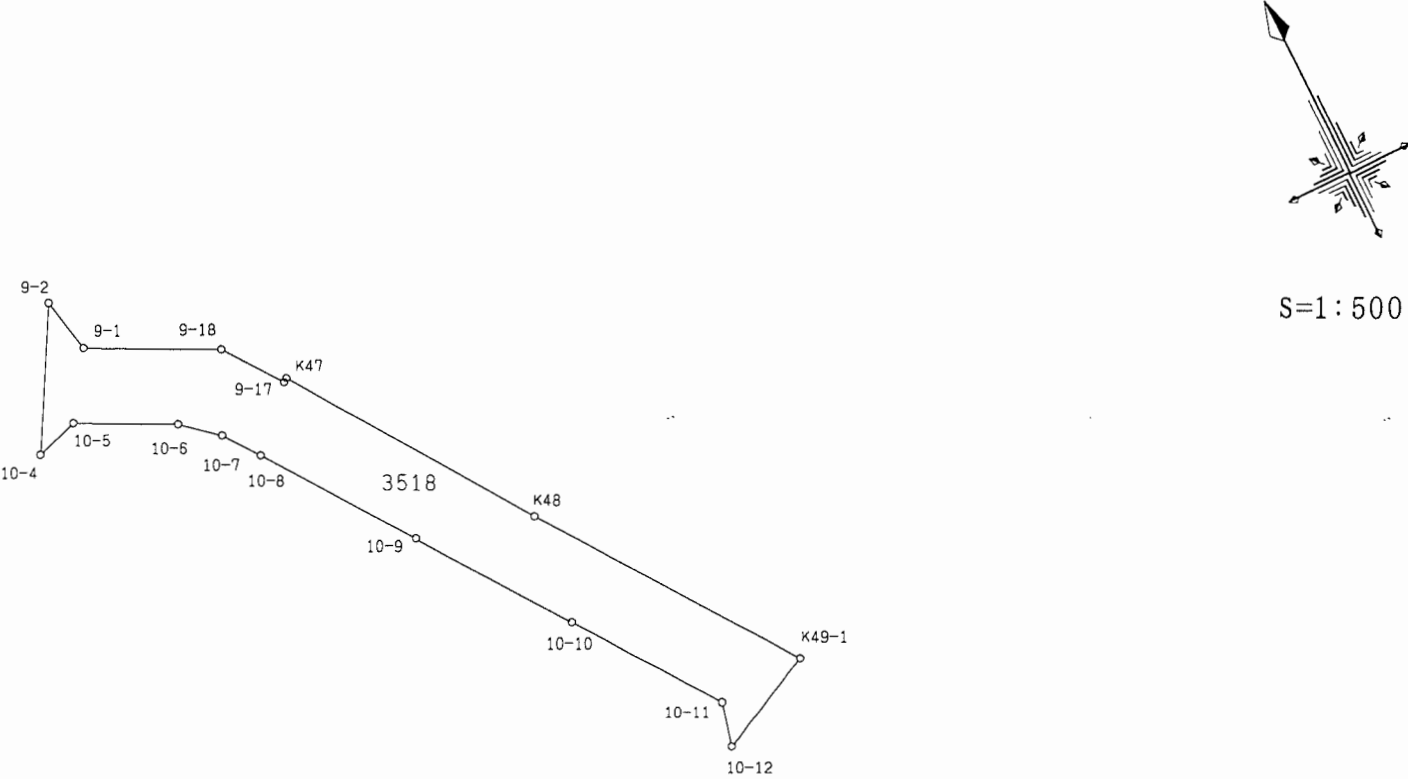

参考資料

※記載内容は換地処分当時のものです。 上尾市

画地面積計算書

現場名：上尾市中平塚区画整理地内

画地番号：3518

参考資料

※記載内容は換地処分当時のものです。上尾市

点名	X _n	Y _n	距離	方向角	測角	X _{n+1} —X _{n-1}	Y _{n+1} —Y _{n-1}	Y _n *(X _{n+1} —X _{n-1})	X _n *(Y _{n+1} —Y _{n-1})
10-4	-1695.548	-20374.378	3.001	71°39'37"	42°35'15"	-7.855	-2.043	160040.739190	3464.004564
10-5	-1694.604	-20371.529	6.886	116°57'28"	225°17'51"	-2.177	8.987	44348.818633	-15229.406148
10-6	-1697.725	-20365.391	2.990	130°45'06"	193°47'38"	-5.073	8.402	103313.628543	-14264.285450
10-7	-1699.677	-20363.127	2.842	144°09'02"	193°23'56"	-4.256	3.929	86665.468512	-6678.030933
10-8	-1701.981	-20361.462	11.669	144°16'29"	180°07'27"	-11.777	8.478	239796.937974	-14429.394918
10-9	-1711.454	-20354.649	11.708	144°13'42"	179°57'13"	-18.972	13.657	386168.400828	-23373.327278
10-10	-1720.953	-20347.805	11.265	144°13'37"	179°59'55"	-18.639	13.429	379262.737395	-23110.677837
10-11	-1730.093	-20341.220	2.994	194°00'40"	229°47'03"	-12.045	5.860	245009.994900	-10138.344980
10-12	-1732.998	-20341.945	7.355	63°36'40"	49°36'00"	0.364	5.864	-7404.467980	-10162.300272
K49-1	-1729.729	-20335.356	19.860	324°19'34"	80°42'54"	19.402	-4.993	-394546.577112	8636.536897
K48	-1713.596	-20346.938	18.845	325°13'04"	180°53'30"	31.611	-22.332	-643187.057118	38268.025872
K47	-1698.118	-20357.688	0.317	234°04'05"	88°51'01"	15.292	-11.007	-311309.764896	18691.184826
9-17	-1698.304	-20357.945	4.664	324°21'23"	270°17'18"	3.604	-2.974	-73370.033780	5050.756096
9-18	-1694.514	-20360.662	9.048	296°51'53"	152°30'30"	7.879	-10.789	-160421.655898	18282.111546
9-1	-1690.425	-20368.734	3.752	348°26'51"	231°34'58"	7.765	-8.824	-158163.219510	14916.310200
9-2	-1686.749	-20369.486	10.068	209°04'22"	40°37'31"	-5.123	-5.644	104352.876778	9520.011356

倍面積	556.826459
面積	278.4132295
地積	278.41㎡