
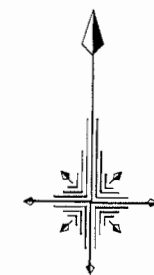


上尾市中平塚土地区画整理事業出来形確認測量

画地原子図

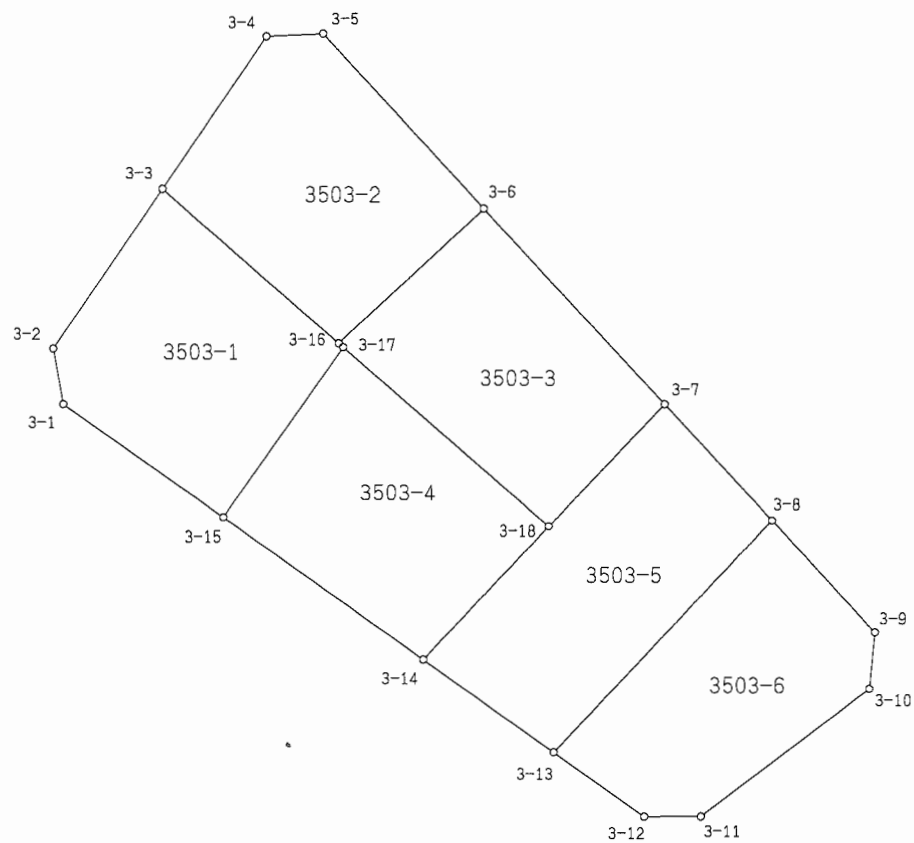

S=1:400

参考資料

※記載内容は換地処分当時のものです。 上尾市

画地面積計算書

現場名： 上尾市中平塚区画整理地内

画地番号： 3503-1 (3-1)

参考資料

※記載内容は換地処分当時のものです。 上尾市

点名	Xn	Yn	距離	方向角	測角	Xn+1-Xn-1	Yn+1-Yn-1	Yn*(Xn+1-Xn-1)	Xn*(Yn+1-Yn-1)
3-1	-1611.212	-20421.447	10.366	124°37'50"	135°45'20"	-8.832	9.108	180362.219904	-14674.918896
3-15	-1617.103	-20412.917	11.031	34°20'12"	89°42'22"	3.218	14.752	-65688.766906	-23855.503456
3-17	-1607.994	-20406.695	0.318	310°50'37"	96°30'25"	9.317	5.981	-190129.177315	-9617.412114
3-16	-1607.786	-20406.936	12.390	310°26'50"	179°36'13"	8.246	-9.670	-168275.594256	15547.290620
3-3	-1599.748	-20416.365	10.232	213°35'18"	83°08'28"	-0.485	-15.089	9901.937025	24138.597572
3-2	-1608.271	-20422.025	2.997	168°52'30"	135°17'12"	-11.464	-5.082	234118.094600	8173.233222

倍面積	288.713052
面積	144.3565260
地積	144.35㎡

画地番号： 3503-2 (3-2)

点名	Xn	Yn	距離	方向角	測角	Xn+1-Xn-1	Yn+1-Yn-1	Yn*(Xn+1-Xn-1)	Xn*(Yn+1-Yn-1)
3-3	-1599.748	-20416.365	12.390	130°26'50"	96°50'44"	-16.161	4.032	329948.874765	-6450.183936
3-16	-1607.786	-20406.936	10.470	46°22'21"	95°55'31"	-0.814	17.007	16611.245904	-27343.616502
3-6	-1600.562	-20399.358	12.535	316°37'24"	90°15'03"	16.335	-1.031	-333223.512930	1650.179422
3-5	-1591.451	-20407.967	3.006	266°40'47"	130°03'23"	8.937	-11.610	-182386.001079	18476.746110
3-4	-1591.625	-20410.968	9.752	213°36'06"	126°55'19"	-8.297	-8.398	169349.801496	13366.466750

倍面積	300.408156
面積	150.2040780
地積	150.20㎡

画地番号： 3503-3 (3-3)

点名	Xn	Yn	距離	方向角	測角	Xn+1-Xn-1	Yn+1-Yn-1	Yn*(Xn+1-Xn-1)	Xn*(Yn+1-Yn-1)
3-16	-1607.786	-20406.936	0.318	130°50'37"	84°28'16"	-7.432	-7.337	151664.348352	11796.325882
3-17	-1607.994	-20406.695	14.447	130°26'26"	179°35'49"	-9.579	11.236	195475.731405	-18067.420584
3-18	-1617.365	-20395.700	8.919	42°35'12"	92°08'46"	-2.804	17.031	57189.542800	-27545.343315
3-7	-1610.798	-20389.664	14.098	316°33'38"	93°58'26"	16.803	-3.658	-342607.524192	5892.299084
3-6	-1600.562	-20399.358	10.470	226°22'21"	89°48'43"	3.012	-17.272	-61442.866296	27644.906864

倍面積	279.232069
面積	139.6160345
地積	139.61㎡

画地面積計算書

現場名： 上尾市中平塚区画整理地内

画地番号： 3503-4 (3-4)

参考資料

※記載内容は換地処分当時のものです。 上尾市

点名	Xn	Yn	距離	方向角	測角	Xn+1-Xn-1	Yn+1-Yn-1	Yn*(Xn+1-Xn-1)	Xn*(Yn+1-Yn-1)
3-17	-1607.994	-20406.695	11.031	214° 20' 12"	83° 53' 46"	0.262	-17.217	-5346.554090	27684.832698
3-15	-1617.103	-20412.917	12.970	124° 37' 44"	90° 17' 32"	-16.479	4.450	336384.459243	-7196.108350
3-14	-1624.473	-20402.245	9.663	42° 38' 11"	98° 00' 27"	-0.262	17.217	5345.388190	-27968.551641
3-18	-1617.365	-20395.700	14.447	310° 26' 26"	87° 48' 15"	16.479	-4.450	-336100.740300	7197.274250

倍面積	282.553043
面積	141.2765215
地積	141.27㎡

画地番号： 3503-5 (3-5)

点名	Xn	Yn	距離	方向角	測角	Xn+1-Xn-1	Yn+1-Yn-1	Yn*(Xn+1-Xn-1)	Xn*(Yn+1-Yn-1)
3-14	-1624.473	-20402.245	8.461	124° 41' 03"	82° 02' 52"	-11.923	0.413	243255.967135	-670.907349
3-13	-1629.288	-20395.287	16.829	42° 34' 07"	97° 53' 04"	7.579	18.342	-154575.880173	-29884.400496
3-8	-1616.894	-20383.903	8.388	316° 37' 06"	94° 02' 59"	18.490	5.623	-376898.366470	-9091.794962
3-7	-1610.798	-20389.664	8.919	222° 35' 12"	85° 58' 06"	-0.471	-11.797	9603.531744	19002.584006
3-18	-1617.365	-20395.700	9.663	222° 38' 11"	180° 02' 59"	-13.675	-12.581	278911.197500	20348.069065

倍面積	296.449736
面積	148.2248680
地積	148.22㎡

画地番号： 3503-6 (3-6)

点名	Xn	Yn	距離	方向角	測角	Xn+1-Xn-1	Yn+1-Yn-1	Yn*(Xn+1-Xn-1)	Xn*(Yn+1-Yn-1)
3-13	-1629.288	-20395.287	5.874	124° 42' 39"	82° 08' 32"	-15.739	-6.555	321001.422093	10679.982840
3-12	-1632.633	-20390.458	3.004	88° 54' 45"	144° 12' 06"	-3.288	7.832	67043.825904	-12786.781656
3-11	-1632.576	-20387.455	11.166	52° 05' 14"	143° 10' 29"	6.918	11.812	-141040.413690	-19283.987712
3-10	-1625.715	-20378.646	2.996	4° 47' 01"	132° 41' 47"	9.847	9.059	-200668.527162	-14727.352185
3-9	-1622.729	-20378.396	8.024	316° 39' 14"	131° 52' 13"	8.821	-5.257	-179757.831116	8530.686353
3-8	-1616.894	-20383.903	16.829	222° 34' 07"	85° 54' 53"	-6.559	-16.891	133698.019777	27310.956554

倍面積	276.495806
面積	138.2479030
地積	138.24㎡