


上尾市中平塚土地区画整理事業出来形確認測量

画地原子図

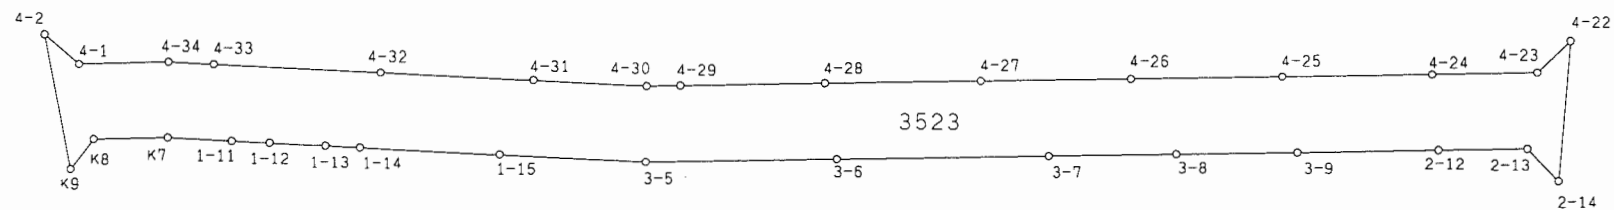

参考資料

※記載内容は換地処分当時のものです。 上尾市

画地面積計算書

現場名：上尾市中平塚区画整理地内

画地番号：3523

参考資料

※記載内容は換地処分当時のものです。 上尾市

点名	X _n	Y _n	距離	方向角	測角	X _{n+1} - X _{n-1}	Y _{n+1} - Y _{n-1}	Y _n * (X _{n+1} - X _{n-1})	X _n * (Y _{n+1} - Y _{n-1})
4-2	-1556.527	-20428.540	9.089	216° 36' 44"	38° 25' 05"	-4.297	-5.515	87781.436380	8584.246405
K9	-1563.823	-20433.960	2.498	85° 03' 37"	48° 26' 53"	-7.081	-2.932	144692.870760	4585.129036
K8	-1563.608	-20431.472	4.901	136° 07' 08"	231° 03' 31"	-3.317	5.885	67771.192624	-9201.833080
K7	-1567.140	-20428.075	4.213	140° 29' 36"	184° 22' 28"	-6.782	6.077	138543.204650	-9523.509780
1-11	-1570.390	-20425.395	2.499	140° 19' 59"	179° 50' 23"	-5.174	4.275	105680.993730	-6713.417250
1-12	-1572.314	-20423.800	3.713	140° 17' 21"	179° 57' 22"	-4.780	3.967	97625.764000	-6237.369638
1-13	-1575.170	-20421.428	2.290	140° 35' 04"	180° 17' 43"	-4.625	3.826	94449.104500	-6026.600420
1-14	-1576.939	-20419.974	9.217	140° 19' 57"	179° 44' 53"	-8.864	7.337	181002.649536	-11570.001443
1-15	-1584.034	-20414.091	9.618	140° 27' 15"	180° 07' 18"	-14.512	12.007	296249.288592	-19019.496238
3-5	-1591.451	-20407.967	12.535	136° 37' 24"	176° 10' 09"	-16.528	14.733	337302.878576	-23446.847583
3-6	-1600.562	-20399.358	14.098	136° 33' 38"	179° 56' 14"	-19.347	18.303	394666.379226	-29295.086286
3-7	-1610.798	-20389.664	8.388	136° 37' 06"	180° 03' 28"	-16.332	15.455	333003.992448	-24894.883090
3-8	-1616.894	-20383.903	8.024	136° 39' 14"	180° 02' 08"	-11.931	11.268	243200.346693	-18219.161592
3-9	-1622.729	-20378.396	9.275	136° 31' 38"	179° 52' 24"	-12.566	11.888	256074.924136	-19291.002352
2-12	-1629.460	-20372.015	5.796	136° 43' 08"	180° 11' 30"	-10.950	10.355	223073.564250	-16873.058300
2-13	-1633.679	-20368.041	2.982	184° 13' 28"	227° 30' 20"	-7.193	3.754	146507.318913	-6132.830966
2-14	-1636.653	-20368.261	9.304	52° 17' 08"	48° 03' 40"	2.718	7.141	-55360.933398	-11687.339073
4-22	-1630.961	-20360.900	3.017	274° 02' 49"	41° 45' 41"	5.905	4.351	-120231.114500	-7096.311311
4-23	-1630.748	-20363.910	6.841	316° 35' 39"	222° 32' 50"	5.183	-7.711	-105546.145530	12574.697828
4-24	-1625.778	-20368.611	9.864	316° 32' 47"	179° 57' 08"	12.130	-11.485	-247071.251430	18672.060330
4-25	-1618.618	-20375.395	10.029	316° 34' 03"	180° 01' 16"	14.443	-13.679	-294281.829985	22141.075622
4-26	-1611.335	-20382.290	9.902	316° 39' 32"	180° 05' 29"	14.485	-13.691	-295237.470650	22060.787485
4-27	-1604.133	-20389.086	10.377	316° 35' 38"	179° 56' 06"	14.741	-13.927	-300555.516726	22340.760291
4-28	-1596.594	-20396.217	9.480	316° 33' 51"	179° 58' 13"	14.423	-13.649	-294174.637791	21791.911506
4-29	-1589.710	-20402.735	2.193	316° 29' 26"	179° 55' 35"	8.474	-8.027	-172892.776390	12760.602170
4-30	-1588.120	-20404.244	7.471	320° 27' 41"	183° 58' 15"	7.351	-6.265	-149991.597644	9949.571800
4-31	-1582.359	-20409.000	10.067	320° 26' 47"	179° 59' 06"	13.524	-11.167	-276011.316000	17670.202953
4-32	-1574.596	-20415.411	11.042	320° 26' 26"	179° 59' 39"	16.276	-13.444	-332281.229436	21168.868624
4-33	-1566.083	-20422.444	2.971	320° 25' 55"	179° 59' 29"	10.803	-8.925	-220623.662532	13977.290775
4-34	-1563.793	-20424.336	5.924	316° 04' 39"	175° 38' 44"	6.557	-6.001	-133922.371152	9384.321793
4-1	-1559.526	-20428.445	3.000	358° 11' 39"	222° 07' 00"	7.266	-4.204	-148433.081370	6556.247304

倍面積	1010.974480
面積	505.4872400
地積	505.48㎡