


画地原子一覽表

S = 1 : 500

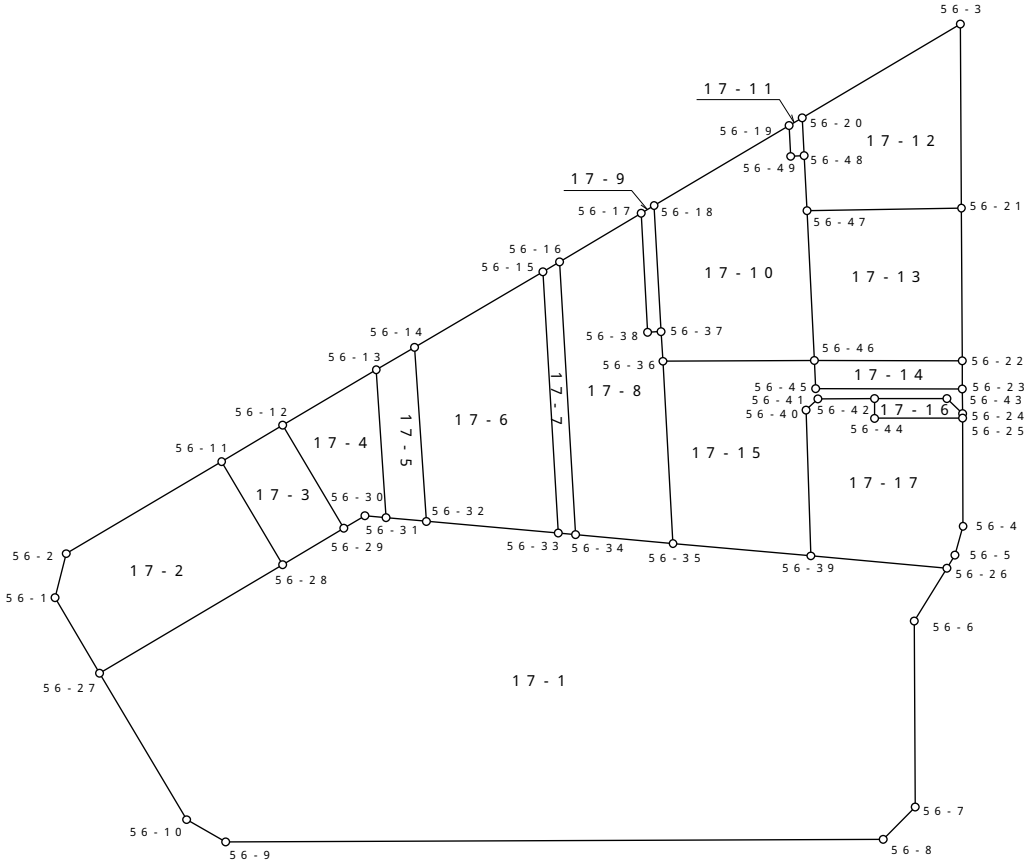

参考資料

※記載内容は換地処分当時のものです。 上尾市

面積（座標法）計算書

地番 = 17-1
測点名

	[1] X(i)	[2] X(i+1)-X(i-1)	[3] Y(i)	[4] Y(i+1)-Y(i-1)	[2]*[3]	[1]*[4]	方向角	夾 角	距 離
56-27	-3707.356	17.882	-22915.945	-2.181	-409782.928490	8085.743436	31-43-35	89-58-23	14.068
56-28	-3695.390	15.983	-22908.547	9.857	-366147.306701	-36425.459230	31-28-22	180-15-13	4.710
56-29	-3691.373	5.399	-22906.088	3.315	-123669.969112	-12236.901495	31-46-26	179-41-56	1.626
56-30	-3689.991	1.912	-22905.232	2.157	-43794.803584	-7959.310587	67-50-06	143-56-20	1.405
56-31	-3689.461	1.547	-22903.931	3.763	-35432.381257	-13883.441743	67-33-20	180-16-46	2.664
56-32	-3688.444	4.378	-22901.469	10.550	-100262.631282	-38913.084200	67-26-04	180-07-16	8.759
56-33	-3685.083	3.801	-22893.381	9.146	-87017.741181	-33703.769118	67-25-07	180-00-57	1.146
56-34	-3684.643	2.904	-22892.323	7.051	-66479.305992	-25980.417793	67-39-01	179-46-06	6.480
56-35	-3682.179	5.971	-22886.330	14.440	-136654.276430	-53170.664760	67-27-10	180-11-51	9.146
56-39	-3678.672	6.958	-22877.883	16.790	-159184.309914	-61764.902880	67-31-41	179-55-29	9.029
56-26	-3675.221	-0.647	-22869.540	8.053	14796.592380	-29596.554713	184-02-52	63-28-49	4.108
56-6	-3679.319	-14.963	-22869.830	5.473	342201.266290	-20136.912887	152-03-28	211-59-24	12.299
56-7	-3690.184	-13.739	-22864.067	4.885	314129.416513	-18026.548840	196-59-16	135-04-12	3.005
56-8	-3693.058	-23.188	-22864.945	-39.320	530192.344660	145211.040560	242-08-48	134-50-28	43.479
56-9	-3713.372	-20.214	-22903.387	-41.421	462969.064818	153811.581612	271-55-21	150-13-27	2.981
56-10	-3713.272	6.016	-22906.366	-12.558	-137804.697856	46631.269776	301-41-58	150-13-23	11.259
合計				倍面積	-1941.667138	1941.667138			136.164
				面 積	970.83	970.83			

面積（座標法）計算書

地番 = 17-2
測点名

	[1] X(i)	[2] X(i+1)-X(i-1)	[3] Y(i)	[4] Y(i+1)-Y(i-1)	[2]*[3]	[1]*[4]	方向角	夾 角	距 離
56-1	-3704.295	5.976	-22920.881	-5.625	-136975.184856	20836.659375	346-42-05	135-06-12	2.995
56-2	-3701.380	13.080	-22921.570	5.590	-299814.135600	-20690.714200	31-42-14	134-59-51	11.948
56-11	-3691.215	5.990	-22915.291	13.023	-137262.593090	-48070.692945	121-45-37	89-56-37	7.932
56-28	-3695.390	-16.141	-22908.547	-0.654	369766.857127	2416.785060	211-43-35	90-02-02	14.068
56-27	-3707.356	-8.905	-22915.945	-12.334	204066.490225	45726.528904	301-48-17	89-55-18	5.808
合計				倍面積	-218.566194	218.566194			42.751
				面 積	109.28	109.28			

面積（座標法）計算書

地番 = 17-3
測点名

	[1] X(i)	[2] X(i+1)-X(i-1)	[3] Y(i)	[4] Y(i+1)-Y(i-1)	[2]*[3]	[1]*[4]	方向角	夾 角	距 離
56-11	-3691.215	8.173	-22915.291	-4.282	-187286.673343	15805.782630	31-37-30	90-08-07	4.695
56-12	-3687.217	-0.158	-22912.829	9.203	3620.226982	-33933.458051	121-39-18	89-58-12	7.919
56-29	-3691.373	-8.173	-22906.088	4.282	187211.457224	-15806.459186	211-28-22	90-10-56	4.710
56-28	-3695.390	0.158	-22908.547	-9.203	-3619.550426	34008.674170	301-45-37	89-42-45	7.932
合計				倍面積	-74.539563	74.539563			25.256
				面 積	37.26	37.26			

面積（座標法）計算書

地番 = 17-4
測点名

	[1] X(i)	[2] X(i+1)-X(i-1)	[3] Y(i)	[4] Y(i+1)-Y(i-1)	[2]*[3]	[1]*[4]	方向角	夾 角	距 離
56-12	-3687.217	10.272	-22912.829	-2.954	-235360.579488	10892.039018	31-45-56	89-53-22	7.194
56-13	-3681.101	-2.244	-22909.042	8.898	51407.890248	-32754.436698	148-33-36	63-12-20	9.799
56-31	-3689.461	-8.890	-22903.931	3.810	203615.946590	-14056.846410	247-50-06	80-43-30	1.405
56-30	-3689.991	-1.912	-22905.232	-2.157	43794.803584	7959.310587	211-46-26	216-03-40	1.626
56-29	-3691.373	2.774	-22906.088	-7.597	-63541.488112	28043.360681	301-39-18	90-07-08	7.919
合計				倍面積	-83.427178	83.427178			27.943
				面 積	41.71	41.71			

面積（座標法）計算書

地番 = 17-5
測点名

	[1] X(i)	[2] X(i+1)-X(i-1)	[3] Y(i)	[4] Y(i+1)-Y(i-1)	[2]*[3]	[1]*[4]	方向角	夾 角	距 離
56-13	-3681.101	10.850	-22909.042	-3.562	-248563.105700	13112.081762	31-53-07	116-40-29	2.932
56-14	-3678.611	-7.343	-22907.493	7.573	168209.721099	-27858.121103	148-30-25	63-22-42	11.532
56-32	-3688.444	-10.850	-22901.469	3.562	248480.938650	-13138.237528	247-33-20	80-57-05	2.664
56-31	-3689.461	7.343	-22903.931	-7.573	-168183.565333	27940.288153	328-33-36	98-59-44	9.799
合計				倍面積	-56.011284	56.011284			26.927
				面 積	28.00	28.00			

面積（座標法）計算書

地番 = 17-6
測点名

	[1] X(i)	[2] X(i+1)-X(i-1)	[3] Y(i)	[4] Y(i+1)-Y(i-1)	[2]*[3]	[1]*[4]	方向角	夾 角	距 離
56-14	-3678.611	18.202	-22907.493	-0.819	-416962.187586	3012.782409	31-52-45	116-37-40	9.856
56-15	-3670.242	-6.472	-22902.288	14.112	148223.607936	-51794.455104	149-01-46	62-50-59	17.309
56-33	-3685.083	-18.202	-22893.381	0.819	416705.320962	-3018.082977	247-26-04	81-35-42	8.759
56-32	-3688.444	6.472	-22901.469	-14.112	-148218.307368	52051.321728	328-30-25	98-55-39	11.532
合計				倍面積	-251.566056	251.566056			47.456
				面 積	125.78	125.78			

面積（座標法）計算書

地番 = 17-7
測点名

	[1] X(i)	[2] X(i+1)-X(i-1)	[3] Y(i)	[4] Y(i+1)-Y(i-1)	[2]*[3]	[1]*[4]	方向角	夾 角	距 離
56-15	-3670.242	15.924	-22902.288	-8.241	-364696.034112	30246.464322	31-35-23	117-26-23	1.271
56-16	-3669.159	-14.401	-22901.622	9.965	329806.258422	-36563.169435	149-00-46	62-34-37	18.062
56-34	-3684.643	-15.924	-22892.323	8.241	364537.351452	-30365.142963	247-25-07	81-35-39	1.146
56-33	-3685.083	14.401	-22893.381	-9.965	-329687.579781	36721.852095	329-01-46	98-23-21	17.309
合計				倍面積	-40.004019	40.004019			37.788
				面 積	20.00	20.00			

面積（座標法）計算書

地番 = 17-8
測点名

	[1] X(i)	[2] X(i+1)-X(i-1)	[3] Y(i)	[4] Y(i+1)-Y(i-1)	[2]*[3]	[1]*[4]	方向角	夾 角	距 離
56-16	-3669.159	20.836	-22901.622	-6.005	-477178.195992	22033.299795	31-36-40	117-24-06	6.284
56-17	-3663.807	-1.421	-22898.328	7.323	32538.524088	-26830.058661	149-15-12	62-21-28	7.881
56-38	-3670.580	-6.316	-22894.299	4.794	144600.392484	-17596.760520	59-08-47	270-06-25	0.891
56-37	-3670.123	-1.229	-22893.534	1.775	28136.153286	-6514.468325	149-04-34	90-04-13	1.965
56-36	-3671.809	-12.056	-22892.524	7.204	275992.269344	-26451.712036	149-09-00	179-55-34	12.079
56-35	-3682.179	-12.834	-22886.330	0.201	293723.159220	-740.117979	247-39-01	81-29-59	6.480
56-34	-3684.643	13.020	-22892.323	-15.292	-298058.045460	56345.560756	329-00-46	98-38-15	18.062
合計				倍面積	-245.743030	245.743030			53.642
				面 積	122.87	122.87			

面積（座標法）計算書

地番 = 17-9
測点名

	[1] X(i)	[2] X(i+1)-X(i-1)	[3] Y(i)	[4] Y(i+1)-Y(i-1)	[2]*[3]	[1]*[4]	方向角	夾 角	距 離
56-17	-3663.807	7.623	-22898.328	-3.506	-174553.954344	12845.307342	31-36-13	117-38-59	0.998
56-18	-3662.957	-6.316	-22897.805	4.794	144622.536380	-17560.215858	149-12-17	62-23-56	8.342
56-37	-3670.123	-7.623	-22893.534	3.506	174517.409682	-12867.451238	239-08-47	90-03-30	0.891
56-38	-3670.580	6.316	-22894.299	-4.794	-144600.392484	17596.760520	329-15-12	89-53-35	7.881
合計				倍面積	-14.400766	14.400766			18.112
				面 積	7.20	7.20			

面積（座標法）計算書

地番 = 17-10
測点名

	[1] X(i)	[2] X(i+1)-X(i-1)	[3] Y(i)	[4] Y(i+1)-Y(i-1)	[2]*[3]	[1]*[4]	方向角	夾 角	距 離
56-18	-3662.957	15.993	-22897.805	1.182	-366204.595365	-4329.615174	31-42-23	117-29-54	10.376
56-19	-3654.130	7.071	-22892.352	6.494	-161871.820992	-23729.920220	149-20-22	62-22-01	2.041
56-49	-3655.886	-1.309	-22891.311	1.799	29964.726099	-6576.938914	59-28-18	269-52-04	0.880
56-48	-3655.439	-2.691	-22890.553	2.609	61598.478123	-9537.040351	149-27-54	90-00-24	3.643
56-47	-3658.577	-11.685	-22888.702	6.890	267454.482870	-25207.595530	149-28-41	179-59-13	9.922
56-46	-3667.124	-13.232	-22883.663	-3.822	302796.628816	14015.747928	242-08-01	87-20-40	10.023
56-36	-3671.809	-2.999	-22892.524	-9.871	68654.679476	36244.426639	329-04-34	93-03-27	1.965
56-37	-3670.123	8.852	-22893.534	-5.281	-202653.562968	19381.919563	329-12-17	179-52-17	8.342
合計				倍面積	-260.983941	260.983941			47.192
				面 積	130.49	130.49			

面積（座標法）計算書

地番 = 17-11
測点名

	[1] X(i)	[2] X(i+1)-X(i-1)	[3] Y(i)	[4] Y(i+1)-Y(i-1)	[2]*[3]	[1]*[4]	方向角	夾 角	距 離
56-19	-3654.130	2.607	-22892.352	-0.515	-59680.361664	1881.876950	31-43-12	117-37-10	1.000
56-20	-3653.279	-1.309	-22891.826	1.799	29965.400234	-6572.248921	149-29-13	62-13-59	2.507
56-48	-3655.439	-2.607	-22890.553	0.515	59675.671671	-1882.551085	239-28-18	90-00-55	0.880
56-49	-3655.886	1.309	-22891.311	-1.799	-29964.726099	6576.938914	329-20-22	90-07-56	2.041
合計				倍面積	-4.015858	4.015858			6.428
				面 積	2.00	2.00			

面積（座標法）計算書

地番 = 17-12
測点名

	[1] X(i)	[2] X(i+1)-X(i-1)	[3] Y(i)	[4] Y(i+1)-Y(i-1)	[2]*[3]	[1]*[4]	方向角	夾 角	距 離
56-20	-3653.279	12.500	-22891.826	5.119	-286147.825000	-18701.135201	31-43-25	117-45-48	12.156
56-3	-3642.939	-0.400	-22885.434	12.098	9154.173600	-44072.276022	152-01-08	59-42-17	12.162
56-21	-3653.679	-15.638	-22879.728	-3.268	357793.186464	11940.222972	241-22-28	90-38-40	10.224
56-47	-3658.577	-1.760	-22888.702	-10.825	40284.115520	39604.096025	329-27-54	91-54-34	3.643
56-48	-3655.439	5.298	-22890.553	-3.124	-121274.149794	11419.591436	329-29-13	179-58-41	2.507
合計				倍面積	-190.499210	190.499210			40.692
				面 積	95.24	95.24			

面積（座標法）計算書

地番 = 17-13
測点名

	[1] X(i)	[2] X(i+1)-X(i-1)	[3] Y(i)	[4] Y(i+1)-Y(i-1)	[2]*[3]	[1]*[4]	方向角	夾 角	距 離
56-47	-3658.577	13.445	-22888.702	3.935	-307738.598390	-14396.500495	61-22-28	88-06-13	10.224
56-21	-3653.679	-4.030	-22879.728	13.705	92205.303840	-50073.670695	152-04-50	89-17-38	10.104
56-22	-3662.607	-13.445	-22874.997	-3.935	307554.334665	14412.358545	242-28-12	89-36-38	9.773
56-46	-3667.124	4.030	-22883.663	-13.705	-92221.161890	50257.934420	329-28-41	92-59-31	9.922
合計				倍面積	-200.121775	200.121775			40.023
				面 積	100.06	100.06			

面積（座標法）計算書

地番 = 17-14
測点名

	[1] X(i)	[2] X(i+1)-X(i-1)	[3] Y(i)	[4] Y(i+1)-Y(i-1)	[2]*[3]	[1]*[4]	方向角	夾 角	距 離
56-46	-3667.124	6.114	-22883.663	7.729	-139910.715582	-28343.201396	62-28-12	87-07-44	9.773
56-22	-3662.607	2.882	-22874.997	9.533	-65925.741354	-34915.632531	152-03-51	90-24-21	1.851
56-23	-3664.242	-6.114	-22874.130	-7.729	139852.430820	28320.926418	242-28-41	89-35-10	9.693
56-45	-3668.721	-2.882	-22882.726	-9.533	65948.016332	34973.917293	329-35-56	92-52-45	1.852
合計				倍面積	-36.009784	36.009784			23.169
				面 積	18.00	18.00			

面積（座標法）計算書

地番 = 17-15
測点名

	[1] X(i)	[2] X(i+1)-X(i-1)	[3] Y(i)	[4] Y(i+1)-Y(i-1)	[2]*[3]	[1]*[4]	方向角	夾 角	距 離
56-36	-3671.809	15.055	-22892.524	2.667	-344646.948820	-9792.714603	62-08-01	87-00-59	10.023
56-46	-3667.124	3.088	-22883.663	9.798	-70664.751344	-35930.480952	149-35-56	92-32-05	1.852
56-45	-3668.721	2.882	-22882.726	9.533	-65948.016332	-34973.917293	62-28-41	267-07-15	9.693
56-23	-3664.242	3.040	-22874.130	9.358	-69537.355200	-34289.976636	152-05-50	90-22-51	1.628
56-24	-3665.681	-1.050	-22873.368	-0.606	24017.036400	2221.402686	285-52-24	46-13-26	1.422
56-43	-3665.292	-1.833	-22874.736	-5.609	41929.391088	20558.622828	242-20-54	223-31-30	4.788
56-42	-3667.514	-3.964	-22878.977	-7.552	90692.264828	27697.065728	242-15-00	180-05-54	3.741
56-41	-3669.256	-2.759	-22882.288	-3.666	63132.232592	13451.492496	199-14-32	223-00-28	1.077
56-40	-3670.273	-9.416	-22882.643	4.405	215462.966488	-16167.552565	150-27-30	228-47-02	9.654
56-39	-3678.672	-11.906	-22877.883	-3.687	272384.074998	13563.263664	247-27-10	83-00-20	9.146
56-35	-3682.179	6.863	-22886.330	-14.641	-157068.882790	53910.782739	329-09-00	98-18-10	12.079
合計				倍面積	-247.988092	247.988092			65.103
				面 積	123.99	123.99			

面積（座標法）計算書

地番 = 17-16
測点名

	[1] X(i)	[2] X(i+1)-X(i-1)	[3] Y(i)	[4] Y(i+1)-Y(i-1)	[2]*[3]	[1]*[4]	方向角	夾 角	距 離
56-42	-3667.514	3.369	-22878.977	3.640	-77079.273513	-13349.750960	62-20-54	89-59-54	4.788
56-43	-3665.292	1.833	-22874.736	5.609	-41929.391088	-20558.622828	105-52-24	136-28-30	1.422
56-24	-3665.681	-0.659	-22873.368	1.512	15073.549512	-5542.509672	151-55-39	133-56-45	0.306
56-25	-3665.951	-2.980	-22873.224	-5.008	68162.207520	18359.082608	242-15-19	89-40-20	5.821
56-44	-3668.661	-1.563	-22878.376	-5.753	35758.901688	21105.806733	332-20-48	89-54-31	1.295
合計				倍面積	-14.005881	14.005881			13.632
				面 積	7.00	7.00			

面積（座標法）計算書

地番 = 17-17
測点名

	[1] X(i)	[2] X(i+1)-X(i-1)	[3] Y(i)	[4] Y(i+1)-Y(i-1)	[2]*[3]	[1]*[4]	方向角	夾 角	距 離
56-40	-3670.273	9.416	-22882.643	-4.405	-215462.966488	16167.552565	19-14-32	131-12-58	1.077
56-41	-3669.256	2.759	-22882.288	3.666	-63132.232592	-13451.492496	62-15-00	136-59-32	3.741
56-42	-3667.514	0.595	-22878.977	3.912	-13612.991315	-14347.314768	152-20-48	89-54-12	1.295
56-44	-3668.661	1.563	-22878.376	5.753	-35758.901688	-21105.806733	62-15-19	270-05-29	5.821
56-25	-3665.951	-3.603	-22873.224	8.498	82412.226072	-31153.251598	152-04-32	90-10-47	7.145
56-4	-3672.264	-8.259	-22869.878	3.755	188882.322402	-13789.351320	168-07-50	163-56-42	1.989
56-5	-3674.210	-2.957	-22869.469	0.338	67625.019833	-1241.882980	184-01-02	164-06-48	1.013
56-26	-3675.221	-4.462	-22869.540	-8.414	102043.887480	30923.309494	247-31-41	116-29-21	9.029
56-39	-3678.672	4.948	-22877.883	-13.103	-113199.765084	48201.639216	330-27-30	97-04-11	9.654
合計				倍面積	-203.401380	203.401380			40.764
				面 積	101.70	101.70			