


上尾市中平塚土地区画整理事業出来形確認測量

画地原子図

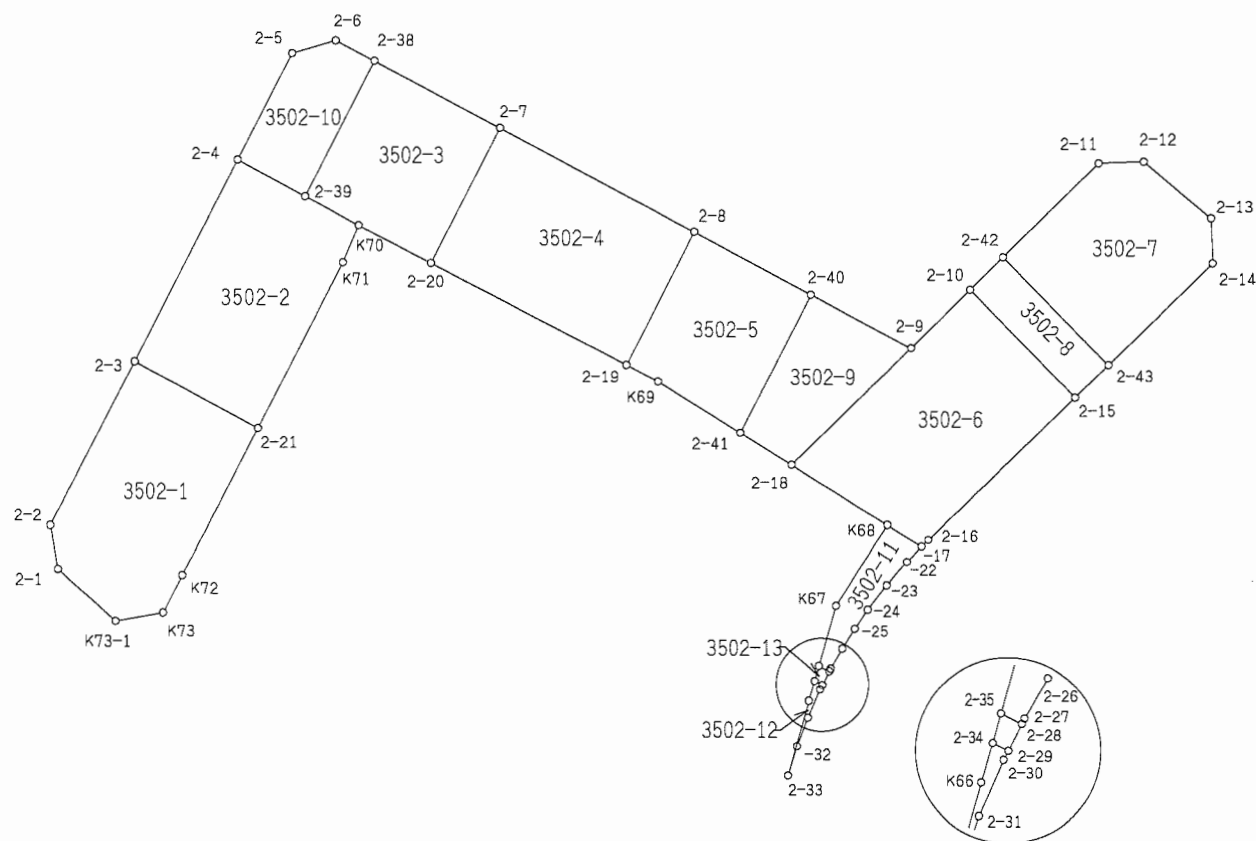

参考資料

※記載内容は換地処分当時のものです。 上尾市

画地面積計算書

現場名：上尾市中平塚区画整理地内

画地番号：3502-1(2-1)

参考資料

※記載内容は換地処分当時のものです。上尾市

| 点名 | Xn | Yn | 距離 | 方向角 | 測角 | Xn+1-Xn-1 | Yn+1-Yn-1 | Yn*(Xn+1-Xn-1) | Xn*(Yn+1-Yn-1) |
|-------|-----------|------------|--------|------------|------------|-----------|-----------|----------------|----------------|
| 2-1 | -1648.153 | -20446.378 | 5.109 | 138°18'56" | 141°17'49" | -6.814 | 3.553 | 139321.619692 | -5855.887609 |
| K73-1 | -1651.969 | -20442.981 | 3.198 | 86°38'02" | 128°19'06" | -3.628 | 6.590 | 74167.135068 | -10886.475710 |
| K73 | -1651.781 | -20439.788 | 2.772 | 33°33'35" | 126°55'33" | 2.498 | 4.725 | -51058.590424 | -7804.665225 |
| K72 | -1649.471 | -20438.256 | 10.995 | 33°34'12" | 180°00'37" | 11.471 | 7.612 | -234447.234576 | -12555.773252 |
| 2-21 | -1640.310 | -20432.176 | 9.282 | 305°02'37" | 91°28'25" | 14.491 | -1.519 | -296082.662416 | 2491.630890 |
| 2-3 | -1634.980 | -20439.775 | 12.216 | 213°35'42" | 88°33'05" | -4.845 | -14.358 | 99030.709875 | 23475.042840 |
| 2-2 | -1645.155 | -20446.534 | 3.002 | 177°01'07" | 143°25'25" | -13.173 | -6.603 | 269342.192382 | 10862.958465 |

| | |
|-----|-------------|
| 倍面積 | 273.169601 |
| 面積 | 136.5848005 |
| 地積 | 136.58 |

画地番号：3502-2(2-2)

| 点名 | Xn | Yn | 距離 | 方向角 | 測角 | Xn+1-Xn-1 | Yn+1-Yn-1 | Yn*(Xn+1-Xn-1) | Xn*(Yn+1-Yn-1) |
|------|-----------|------------|--------|------------|------------|-----------|-----------|----------------|----------------|
| 2-3 | -1634.980 | -20439.775 | 9.282 | 125°02'37" | 91°26'03" | -17.777 | -0.673 | 363357.880175 | 1100.341540 |
| 2-21 | -1640.310 | -20432.176 | 12.321 | 33°36'27" | 88°33'50" | 4.932 | 14.419 | -100771.492032 | -23651.629890 |
| K71 | -1630.048 | -20425.356 | 2.651 | 29°43'46" | 176°07'19" | 12.564 | 8.134 | -256624.172784 | -13258.810432 |
| K70 | -1627.746 | -20424.042 | 4.031 | 304°56'37" | 95°12'51" | 4.611 | -1.990 | -94175.257662 | 3239.214540 |
| 2-39 | -1625.437 | -20427.346 | 5.071 | 304°56'37" | 180°00'00" | 5.213 | -7.461 | -106487.754698 | 12127.385457 |
| 2-4 | -1622.533 | -20431.503 | 14.945 | 213°36'34" | 88°39'57" | -9.543 | -12.429 | 194977.833129 | 20166.462657 |

| | |
|-----|-------------|
| 倍面積 | 277.036128 |
| 面積 | 138.5180640 |
| 地積 | 138.51 |

画地番号：3502-3(2-3)

| 点名 | Xn | Yn | 距離 | 方向角 | 測角 | Xn+1-Xn-1 | Yn+1-Yn-1 | Yn*(Xn+1-Xn-1) | Xn*(Yn+1-Yn-1) |
|------|-----------|------------|--------|------------|------------|-----------|-----------|----------------|----------------|
| 2-39 | -1625.437 | -20427.346 | 4.031 | 124°56'37" | 91°20'38" | -10.689 | -2.265 | 218347.901394 | 3681.614805 |
| K70 | -1627.746 | -20424.042 | 5.384 | 124°00'46" | 179°04'09" | -5.321 | 7.767 | 108676.327482 | -12642.703182 |
| 2-20 | -1630.758 | -20419.579 | 10.015 | 33°35'39" | 89°34'53" | 5.331 | 10.005 | -108856.775649 | -16315.733790 |
| 2-7 | -1622.415 | -20414.037 | 9.414 | 304°41'52" | 91°06'13" | 13.701 | -2.198 | -279692.720937 | 3566.068170 |
| 2-38 | -1617.057 | -20421.777 | 10.062 | 213°35'59" | 88°54'07" | -3.022 | -13.309 | 61714.610094 | 21521.411613 |

| | |
|-----|------------|
| 倍面積 | 189.342384 |
| 面積 | 94.6711920 |
| 地積 | 94.67 |

画地面積計算書

現場名：上尾市中平塚区画整理地内

画地番号：3502-4(2-4)

参考資料

※記載内容は換地処分当時のものです。上尾市

| 点名 | Xn | Yn | 距離 | 方向角 | 測角 | X _{n+1} -X _{n-1} | Y _{n+1} -Y _{n-1} | Y _n *(X _{n+1} -X _{n-1}) | X _n *(Y _{n+1} -Y _{n-1}) |
|------|-----------|------------|--------|------------|-----------|------------------------------------|------------------------------------|---|---|
| 2-20 | -1630.758 | -20419.579 | 14.561 | 123°58'08" | 90°22'29" | -16.479 | 6.534 | 336494.242341 | -10655.372772 |
| 2-19 | -1638.894 | -20407.503 | 9.841 | 33°34'16" | 89°36'08" | 0.064 | 17.518 | -1306.080192 | -28710.145092 |
| 2-8 | -1630.694 | -20402.061 | 14.559 | 304°39'13" | 91°04'57" | 16.479 | -6.534 | -336205.563219 | 10654.954596 |
| 2-7 | -1622.415 | -20414.037 | 10.015 | 213°35'39" | 88°56'26" | -0.064 | -17.518 | 1306.498368 | 28421.465970 |

| | |
|-----|-------------|
| 倍面積 | 289.097298 |
| 面積 | 144.5486490 |
| 地積 | 144.54㎡ |

画地番号：3502-5(2-5)

| 点名 | Xn | Yn | 距離 | 方向角 | 測角 | X _{n+1} -X _{n-1} | Y _{n+1} -Y _{n-1} | Y _n *(X _{n+1} -X _{n-1}) | X _n *(Y _{n+1} -Y _{n-1}) |
|------|-----------|------------|--------|------------|------------|------------------------------------|------------------------------------|---|---|
| 2-19 | -1638.894 | -20407.503 | 2.366 | 124°26'13" | 90°51'57" | -9.537 | -3.491 | 194626.356111 | 5721.378954 |
| K69 | -1640.231 | -20405.552 | 6.414 | 128°41'30" | 184°15'17" | -5.347 | 6.958 | 109108.486544 | -11412.727298 |
| 2-41 | -1644.241 | -20400.545 | 10.280 | 33°33'54" | 84°52'24" | 4.555 | 10.690 | -92924.482475 | -17576.936290 |
| 2-40 | -1635.676 | -20394.862 | 8.755 | 304°40'51" | 91°06'57" | 13.547 | -1.516 | -276289.195514 | 2479.684816 |
| 2-8 | -1630.694 | -20402.061 | 9.841 | 213°34'16" | 88°53'25" | -3.218 | -12.641 | 65653.832298 | 20613.602854 |

| | |
|-----|------------|
| 倍面積 | 174.996964 |
| 面積 | 87.4984820 |
| 地積 | 87.49㎡ |

画地番号：3502-6(2-6)

| 点名 | Xn | Yn | 距離 | 方向角 | 測角 | X _{n+1} -X _{n-1} | Y _{n+1} -Y _{n-1} | Y _n *(X _{n+1} -X _{n-1}) | X _n *(Y _{n+1} -Y _{n-1}) |
|------|-----------|------------|--------|------------|------------|------------------------------------|------------------------------------|---|---|
| 2-18 | -1646.739 | -20397.426 | 7.481 | 128°48'50" | 76°45'22" | -11.491 | -2.895 | 234386.822166 | 4767.309405 |
| K68 | -1651.428 | -20391.597 | 2.693 | 128°46'12" | 179°57'22" | -6.376 | 7.929 | 130016.822472 | -13094.172612 |
| 2-17 | -1653.115 | -20389.497 | 0.624 | 50°58'28" | 102°12'16" | -1.294 | 2.585 | 26384.009118 | -4273.302275 |
| 2-16 | -1652.722 | -20389.012 | 13.558 | 52°13'34" | 181°15'06" | 8.698 | 11.201 | -177343.626376 | -18512.139122 |
| 2-15 | -1644.417 | -20378.296 | 9.950 | 322°13'59" | 90°00'25" | 16.171 | 4.623 | -329537.424616 | -7602.139791 |
| 2-10 | -1636.551 | -20384.389 | 5.483 | 231°51'57" | 89°37'58" | 4.480 | -10.406 | -91322.062720 | 17029.949706 |
| 2-9 | -1639.937 | -20388.702 | 11.062 | 232°03'28" | 180°11'31" | -10.188 | -13.037 | 207720.095976 | 21379.858669 |

| | |
|-----|-------------|
| 倍面積 | 304.636020 |
| 面積 | 152.3180100 |
| 地積 | 152.31㎡ |

画地面積計算書

現場名：上尾市中平塚区画整理地内

画地番号：3502-7(2-7)

参考資料

※記載内容は換地処分当時のものです。上尾市

| 点名 | Xn | Yn | 距離 | 方向角 | 測角 | Xn+1-Xn-1 | Yn+1-Yn-1 | Yn*(Xn+1-Xn-1) | Xn*(Yn+1-Yn-1) |
|------|-----------|------------|-------|------------|------------|-----------|-----------|----------------|----------------|
| 2-42 | -1634.664 | -20381.971 | 9.963 | 142°13'59" | 90°12'41" | -13.320 | -0.872 | 271487.853720 | 1425.427008 |
| 2-43 | -1642.540 | -20375.869 | 9.620 | 52°16'20" | 90°02'21" | -1.989 | 13.710 | 40527.603441 | -22519.223400 |
| 2-14 | -1636.653 | -20368.261 | 2.982 | 4°13'28" | 131°57'08" | 8.861 | 7.828 | -180483.160721 | -12811.719684 |
| 2-13 | -1633.679 | -20368.041 | 5.796 | 316°43'08" | 132°29'40" | 7.193 | -3.754 | -146507.318913 | 6132.830966 |
| 2-12 | -1629.460 | -20372.015 | 2.992 | 274°36'29" | 137°53'21" | 4.459 | -6.956 | -90838.814885 | 11334.523760 |
| 2-11 | -1629.220 | -20374.997 | 8.847 | 232°01'18" | 137°24'49" | -5.204 | -9.956 | 106031.484388 | 16220.514320 |

| | |
|-----|-------------|
| 倍面積 | 217.647030 |
| 面積 | 108.8235150 |
| 地積 | 108.82㎡ |

画地番号：3502-8(2-8)

| 点名 | Xn | Yn | 距離 | 方向角 | 測角 | Xn+1-Xn-1 | Yn+1-Yn-1 | Yn*(Xn+1-Xn-1) | Xn*(Yn+1-Yn-1) |
|------|-----------|------------|-------|------------|-----------|-----------|-----------|----------------|----------------|
| 2-10 | -1636.551 | -20384.389 | 9.950 | 142°13'59" | 90°12'41" | -9.753 | 3.675 | 198808.945917 | -6014.324925 |
| 2-15 | -1644.417 | -20378.296 | 3.067 | 52°16'20" | 90°02'21" | -5.989 | 8.520 | 122045.614744 | -14010.432840 |
| 2-43 | -1642.540 | -20375.869 | 9.963 | 322°13'59" | 89°57'39" | 9.753 | -3.675 | -198725.850357 | 6036.334500 |
| 2-42 | -1634.664 | -20381.971 | 3.067 | 232°01'18" | 89°47'19" | 5.989 | -8.520 | -122067.624319 | 13927.337280 |

| | |
|-----|------------|
| 倍面積 | 61.085985 |
| 面積 | 30.5429925 |
| 地積 | 30.54㎡ |

画地番号：3502-9(2-9)

| 点名 | Xn | Yn | 距離 | 方向角 | 測角 | Xn+1-Xn-1 | Yn+1-Yn-1 | Yn*(Xn+1-Xn-1) | Xn*(Yn+1-Yn-1) |
|------|-----------|------------|--------|------------|------------|-----------|-----------|----------------|----------------|
| 2-41 | -1644.241 | -20400.545 | 3.996 | 128°41'30" | 95°07'36" | -11.063 | -2.564 | 225691.229335 | 4215.833924 |
| 2-18 | -1646.739 | -20397.426 | 11.062 | 52°03'28" | 103°21'58" | 4.304 | 11.843 | -87790.521504 | -19502.329977 |
| 2-9 | -1639.937 | -20388.702 | 7.490 | 304°40'51" | 72°37'23" | 11.063 | 2.564 | -225560.210226 | -4204.798468 |
| 2-40 | -1635.676 | -20394.862 | 10.280 | 213°33'54" | 88°53'03" | -4.304 | -11.843 | 87779.486048 | 19371.310868 |

| | |
|-----|------------|
| 倍面積 | 119.983653 |
| 面積 | 59.9918265 |
| 地積 | 59.99㎡ |

画地面積計算書

現場名：上尾市中平塚区画整理地内

画地番号：3502-10(2-10)

参考資料

※記載内容は換地処分当時のものです。上尾市

| 点名 | Xn | Yn | 距離 | 方向角 | 測角 | Xn+1-Xn-1 | Yn+1-Yn-1 | Yn*(Xn+1-Xn-1) | Xn*(Yn+1-Yn-1) |
|------|-----------|------------|--------|------------|------------|-----------|-----------|----------------|----------------|
| 2-4 | -1622.533 | -20431.503 | 5.071 | 124°56'37" | 91°23'40" | -9.509 | -0.223 | 194283.162027 | 361.824859 |
| 2-39 | -1625.437 | -20427.346 | 10.062 | 33°35'59" | 88°39'22" | 5.476 | 9.726 | -111860.146696 | -15809.000262 |
| 2-38 | -1617.057 | -20421.777 | 2.902 | 304°41'52" | 91°05'53" | 10.032 | 3.183 | -204871.266864 | -5147.092431 |
| 2-6 | -1615.405 | -20424.163 | 3.006 | 259°57'49" | 135°15'57" | 1.129 | -5.346 | -23058.880027 | 8635.955130 |
| 2-5 | -1615.928 | -20427.123 | 7.925 | 213°32'57" | 133°35'08" | -7.128 | -7.340 | 145604.532744 | 11860.911520 |

| | |
|-----|------------|
| 倍面積 | 97.401184 |
| 面積 | 48.7005920 |
| 地積 | 48.70㎡ |

画地番号：3502-11(2-11)

| 点名 | Xn | Yn | 距離 | 方向角 | 測角 | Xn+1-Xn-1 | Yn+1-Yn-1 | Yn*(Xn+1-Xn-1) | Xn*(Yn+1-Yn-1) |
|------|-----------|------------|-------|------------|------------|-----------|-----------|----------------|----------------|
| 2-35 | -1660.173 | -20397.127 | 0.776 | 123°41'45" | 101°23'18" | -4.217 | -0.908 | 86014.684559 | 1507.437084 |
| 2-28 | -1660.603 | -20396.482 | 0.200 | 33°12'28" | 89°30'43" | -0.263 | 0.755 | 5364.274766 | -1253.755265 |
| 2-27 | -1660.436 | -20396.372 | 1.527 | 36°34'50" | 183°22'22" | 1.393 | 1.020 | -28412.146196 | -1693.644720 |
| 2-26 | -1659.210 | -20395.462 | 1.527 | 38°55'27" | 182°20'37" | 2.414 | 1.869 | -49234.645268 | -3101.063490 |
| 2-25 | -1658.022 | -20394.503 | 1.531 | 40°38'16" | 181°42'49" | 2.350 | 1.956 | -47927.082050 | -3243.091032 |
| 2-24 | -1656.860 | -20393.506 | 2.040 | 43°49'54" | 183°11'38" | 2.634 | 2.410 | -53716.494804 | -3993.032600 |
| 2-23 | -1655.388 | -20392.093 | 2.047 | 47°20'19" | 183°30'25" | 2.859 | 2.919 | -58300.993887 | -4832.077572 |
| 2-22 | -1654.001 | -20390.587 | 1.405 | 50°53'07" | 183°32'48" | 2.273 | 2.596 | -46347.804251 | -4293.786596 |
| 2-17 | -1653.115 | -20389.497 | 2.693 | 308°46'12" | 77°53'05" | 2.573 | -1.010 | -52462.175781 | 1669.646150 |
| K68 | -1651.428 | -20391.597 | 6.355 | 218°44'03" | 89°57'51" | -3.271 | -6.077 | 66700.913787 | 10035.727956 |
| K67 | -1656.386 | -20395.574 | 4.093 | 202°18'27" | 163°34'24" | -8.745 | -5.530 | 178359.294630 | 9159.814580 |

| | |
|-----|------------|
| 倍面積 | 37.825505 |
| 面積 | 18.9127525 |
| 地積 | 18.91㎡ |

画地番号：3502-12(2-12)

| 点名 | Xn | Yn | 距離 | 方向角 | 測角 | Xn+1-Xn-1 | Yn+1-Yn-1 | Yn*(Xn+1-Xn-1) | Xn*(Yn+1-Yn-1) |
|------|-----------|------------|-------|------------|------------|-----------|-----------|----------------|----------------|
| 2-34 | -1661.116 | -20397.515 | 1.362 | 202°25'11" | 78°43'26" | -0.935 | -1.005 | 19071.676525 | 1669.421580 |
| K66 | -1662.375 | -20398.034 | 5.137 | 202°12'37" | 179°47'26" | -6.015 | -2.461 | 122694.174510 | 4091.104875 |
| 2-33 | -1667.131 | -20399.976 | 2.022 | 23°34'05" | 1°21'28" | -2.902 | -1.133 | 59200.730352 | 1888.859423 |
| 2-32 | -1665.277 | -20399.167 | 2.031 | 27°15'16" | 183°41'11" | 3.660 | 1.739 | -74660.951220 | -2895.916703 |
| 2-31 | -1663.471 | -20398.237 | 2.029 | 30°19'37" | 183°04'21" | 3.557 | 1.955 | -72556.529009 | -3252.085805 |
| 2-30 | -1661.720 | -20397.212 | 0.334 | 33°12'28" | 182°52'51" | 2.031 | 1.208 | -41426.737572 | -2007.357760 |
| 2-29 | -1661.440 | -20397.029 | 0.584 | 303°41'45" | 90°29'17" | 0.604 | -0.303 | -12319.805516 | 503.416320 |

| | |
|-----|-----------|
| 倍面積 | 2.558070 |
| 面積 | 1.2790350 |
| 地積 | 1.27㎡ |

画地面積計算書

現場名： 上尾市中平塚区画整理地内

画地番号： 3502-13(2-13)

参考資料

※記載内容は換地処分当時のものです。 上尾市

| 点名 | Xn | Yn | 距離 | 方向角 | 測角 | Xn+1-Xn-1 | Yn+1-Yn-1 | Yn*(Xn+1-Xn-1) | Xn*(Yn+1-Yn-1) |
|------|-----------|------------|-------|--------------|--------------|-----------|-----------|----------------|----------------|
| 2-34 | -1661.116 | -20397.515 | 0.584 | 123° 41' 45" | 101° 21' 37" | -1.267 | 0.098 | 25843.651505 | -162.789368 |
| 2-29 | -1661.440 | -20397.029 | 1.000 | 33° 12' 28" | 89° 30' 43" | 0.513 | 1.033 | -10463.675877 | -1716.267520 |
| 2-28 | -1660.603 | -20396.482 | 0.776 | 303° 41' 45" | 90° 29' 17" | 1.267 | -0.098 | -25842.342694 | 162.739094 |
| 2-35 | -1660.173 | -20397.127 | 1.020 | 202° 20' 08" | 78° 38' 23" | -0.513 | -1.033 | 10463.726151 | 1714.958709 |

| | |
|-----|-----------|
| 倍面積 | 1.359085 |
| 面積 | 0.6795425 |
| 地積 | 0.67㎡ |