



上尾市中平塚土地区画整理事業出来形確認測量

画地原子図

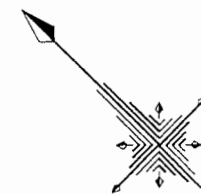

S=1:500

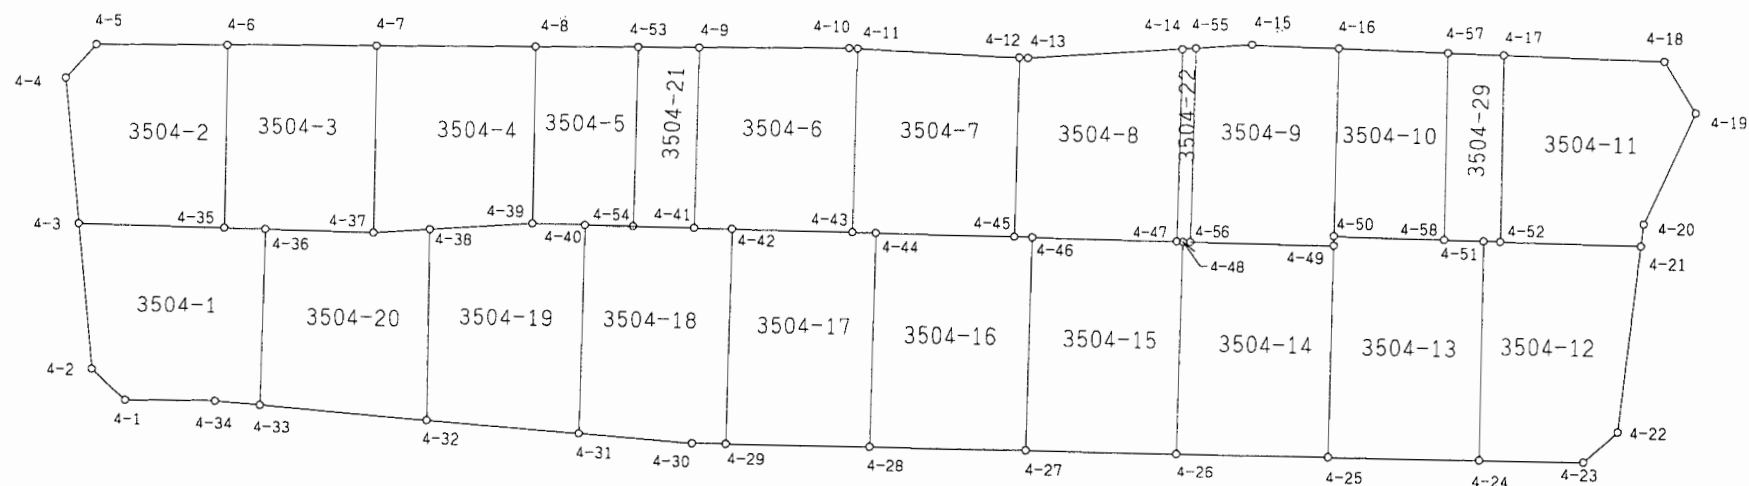

参考資料

※記載内容は換地処分当時のものです。 上尾市

画地面積計算書

現場名：上尾市中平塚区画整理地内

画地番号：3504-1(4-1)

参考資料

※記載内容は換地処分当時のものです。上尾市

点名	Xn	Yn	距離	方向角	測角	Xn+1-Xn-1	Yn+1-Yn-1	Yn*(Xn+1-Xn-1)	Xn*(Yn+1-Yn-1)
4-2	-1556.527	-20428.540	3.000	178°11'39"	138°03'43"	-10.422	-6.163	212906.243880	9592.875901
4-1	-1559.526	-20428.445	5.924	136°04'39"	137°53'00"	-7.266	4.204	148433.081370	-6556.247304
4-34	-1563.793	-20424.336	2.971	140°25'55"	184°21'16"	-6.557	6.001	133922.371152	-9384.321793
4-33	-1566.083	-20422.444	11.656	46°55'47"	86°29'52"	5.669	10.407	-115774.835036	-16298.225781
4-36	-1558.124	-20413.929	2.709	317°09'24"	90°13'37"	9.946	6.673	-203036.937834	-10397.361452
4-35	-1556.137	-20415.771	9.584	317°12'30"	180°03'06"	9.020	-8.353	-184150.254420	12998.412361
4-3	-1549.104	-20422.282	9.709	220°07'56"	82°55'26"	-0.390	-12.769	7964.689980	19780.508976

倍面積	264.359092
面積	132.1795460
地積	132.17㎡

画地番号：3504-2(4-2)

点名	Xn	Yn	距離	方向角	測角	Xn+1-Xn-1	Yn+1-Yn-1	Yn*(Xn+1-Xn-1)	Xn*(Yn+1-Yn-1)
4-3	-1549.104	-20422.282	9.584	137°12'30"	96°59'07"	-14.442	0.244	294938.596644	-377.981376
4-35	-1556.137	-20415.771	12.133	46°15'01"	89°02'31"	1.357	15.275	-27704.201247	-23769.992675
4-6	-1547.747	-20407.007	8.619	315°41'49"	89°26'48"	14.558	2.744	-297085.207906	-4247.017768
4-5	-1541.579	-20413.027	2.991	267°47'24"	132°05'35"	6.052	-9.008	-123539.639404	13886.543632
4-4	-1541.695	-20416.015	9.704	220°13'23"	132°25'59"	-7.525	-9.255	153630.512875	14268.387225

倍面積	240.060962
面積	120.0304810
地積	120.03㎡

画地番号：3504-3(4-3)

点名	Xn	Yn	距離	方向角	測角	Xn+1-Xn-1	Yn+1-Yn-1	Yn*(Xn+1-Xn-1)	Xn*(Yn+1-Yn-1)
4-35	-1556.137	-20415.771	2.709	137°09'24"	90°54'23"	-10.377	-6.922	211854.455667	10771.580314
4-36	-1558.124	-20413.929	7.153	137°10'13"	180°00'49"	-7.232	6.705	147633.534528	-10447.221420
4-37	-1563.369	-20409.066	12.392	46°15'09"	89°04'56"	3.323	13.814	-67819.326318	-21596.379366
4-7	-1554.801	-20400.115	9.862	315°39'44"	89°24'35"	15.622	2.059	-318690.596530	-3201.335259
4-6	-1547.747	-20407.007	12.133	226°15'01"	90°35'17"	-1.336	-15.656	27263.761352	24231.527032

倍面積	241.828699
面積	120.9143495
地積	120.91㎡

画地面積計算書

現場名：上尾市中平塚区画整理地内

画地番号：3504-4(4-4)

参考資料

※記載内容は換地処分当時のものです。上尾市

点名	Xn	Yn	距離	方向角	測角	X _{n+1} -X _{n-1}	Y _{n+1} -Y _{n-1}	Y _n *(X _{n+1} -X _{n-1})	X _n *(Y _{n+1} -Y _{n-1})
4-37	-1563.369	-20409.066	3.706	132°01'47"	85°46'38"	-11.050	-6.198	225520.179300	9689.761062
4-38	-1565.851	-20406.313	6.787	132°00'46"	179°58'59"	-7.024	7.796	143333.942512	-12207.374396
4-39	-1570.393	-20401.270	11.730	46°13'35"	94°12'49"	3.573	13.513	-72893.737710	-21220.720609
4-8	-1562.278	-20392.800	10.460	315°37'57"	89°24'22"	15.592	1.155	-317964.537600	-1804.431090
4-7	-1554.801	-20400.115	12.392	226°15'09"	90°37'12"	-1.091	-16.266	22256.525465	25290.393066

倍面積	252.371967
面積	126.1859835
地積	126.18㎡

画地番号：3504-5(4-5)

点名	Xn	Yn	距離	方向角	測角	X _{n+1} -X _{n-1}	Y _{n+1} -Y _{n-1}	Y _n *(X _{n+1} -X _{n-1})	X _n *(Y _{n+1} -Y _{n-1})
4-39	-1570.393	-20401.270	3.452	136°52'45"	90°39'10"	-10.635	-6.111	216967.506450	9596.671623
4-40	-1572.913	-20398.911	3.162	136°56'28"	180°03'43"	-4.830	4.518	98526.740130	-7106.420934
4-54	-1575.223	-20396.752	11.879	46°55'29"	89°59'01"	5.803	10.836	-118362.351856	-17069.116428
4-53	-1567.110	-20388.075	6.758	315°38'23"	88°42'54"	12.945	3.952	-263923.630875	-6193.218720
4-8	-1562.278	-20392.800	11.730	226°13'35"	90°35'12"	-3.283	-13.195	66949.562400	20614.258210

倍面積	157.826249
面積	78.9131245
地積	78.91㎡

画地番号：3504-6(4-6)

点名	Xn	Yn	距離	方向角	測角	X _{n+1} -X _{n-1}	Y _{n+1} -Y _{n-1}	Y _n *(X _{n+1} -X _{n-1})	X _n *(Y _{n+1} -Y _{n-1})
4-41	-1578.147	-20394.020	2.486	136°56'10"	90°00'41"	-9.991	-7.046	203756.653820	11119.623762
4-42	-1579.963	-20392.322	7.905	136°54'50"	179°58'40"	-7.590	7.098	154777.723980	-11214.577374
4-43	-1585.737	-20386.922	12.167	46°56'14"	90°01'24"	2.534	14.289	-51660.460348	-22658.595993
4-11	-1577.429	-20378.033	0.563	318°35'10"	91°38'56"	8.730	8.516	-177900.228090	-13433.385364
4-10	-1577.007	-20378.406	9.833	315°40'31"	177°05'21"	7.457	-7.243	-151961.773542	11422.261701
4-9	-1569.972	-20385.276	11.970	226°55'29"	91°14'58"	-1.140	-15.614	23239.214640	24513.542808

倍面積	251.130460
面積	125.5652300
地積	125.56㎡

画地面積計算書

現場名：上尾市中平塚区画整理地内

画地番号：3504-7(4-7)

参考資料

※記載内容は換地処分当時のものです。上尾市

点名	Xn	Yn	距離	方向角	測角	X _{n+1} -X _{n-1}	Y _{n+1} -Y _{n-1}	Y _n *(X _{n+1} -X _{n-1})	X _n *(Y _{n+1} -Y _{n-1})
4-43	-1585.737	-20386.922	1.576	137°04'13"	90°07'59"	-9.461	-7.816	192880.669042	12394.120392
4-44	-1586.890	-20385.849	9.201	136°54'48"	179°50'35"	-7.873	7.358	160497.789177	-11676.336620
4-45	-1593.610	-20379.564	11.876	46°55'16"	90°00'28"	1.391	14.959	-28347.973524	-23838.811990
4-12	-1585.499	-20370.890	10.777	318°29'02"	91°33'46"	16.181	1.531	-329621.371090	-2427.398969
4-11	-1577.429	-20378.033	12.167	226°56'14"	88°27'12"	-0.238	-16.032	4849.971854	25289.341728

倍面積	259.085459
面積	129.5427295
地積	129.54㎡

画地番号：3504-8(4-8)

点名	Xn	Yn	距離	方向角	測角	X _{n+1} -X _{n-1}	Y _{n+1} -Y _{n-1}	Y _n *(X _{n+1} -X _{n-1})	X _n *(Y _{n+1} -Y _{n-1})
4-45	-1593.610	-20379.564	1.181	136°58'25"	90°03'09"	-8.975	-7.868	182906.586900	12538.523480
4-46	-1594.474	-20378.758	9.505	136°55'46"	179°57'21"	-7.807	7.297	159096.963706	-11634.876778
4-47	-1601.417	-20372.267	12.759	46°57'13"	90°01'27"	1.766	15.815	-35977.423522	-25326.409855
4-14	-1592.708	-20362.943	10.169	311°50'16"	84°53'03"	15.492	1.748	-315462.712956	-2784.053584
4-13	-1585.925	-20370.519	0.565	318°58'08"	187°07'52"	7.209	-7.947	-146851.071471	12603.345975
4-12	-1585.499	-20370.890	11.876	226°55'16"	87°57'08"	-7.685	-9.045	156550.289650	14340.838455

倍面積	262.632307
面積	131.3161535
地積	131.31㎡

画地番号：3504-9(4-9)

点名	Xn	Yn	距離	方向角	測角	X _{n+1} -X _{n-1}	Y _{n+1} -Y _{n-1}	Y _n *(X _{n+1} -X _{n-1})	X _n *(Y _{n+1} -Y _{n-1})
4-56	-1602.072	-20371.658	9.478	136°54'19"	89°57'06"	-15.686	-2.910	319549.827388	4662.029520
4-49	-1608.993	-20365.183	0.632	46°54'45"	90°00'26"	-6.489	6.937	132149.672487	-11161.584441
4-50	-1608.561	-20364.721	12.452	46°42'10"	179°47'25"	8.971	9.525	-182691.912091	-15321.543525
4-16	-1600.022	-20355.658	5.735	317°44'51"	91°02'41"	12.784	5.207	-260226.731872	-8331.314554
4-15	-1595.777	-20359.514	3.703	311°50'18"	174°05'27"	6.715	-6.615	-136714.136510	10556.064855
4-55	-1593.307	-20362.273	12.841	226°57'13"	95°06'55"	-6.295	-12.144	128180.508535	19349.120208

倍面積	247.227937
面積	123.6139685
地積	123.61㎡

画地面積計算書

現場名：上尾市中平塚区画整理地内

画地番号：3504-10(4-10)

参考資料

※記載内容は換地処分当時のものです。上尾市

点名	Xn	Yn	距離	方向角	測角	Xn+1-Xn-1	Yn+1-Yn-1	Yn*(Xn+1-Xn-1)	Xn*(Yn+1-Yn-1)
4-50	-1608.561	-20364.721	7.218	137°17'39"	90°35'29"	-13.843	-4.168	281908.832803	6704.482248
4-58	-1613.865	-20359.826	12.390	46°24'47"	89°07'08"	3.239	13.870	-65945.476414	-22384.307550
4-57	-1605.322	-20350.851	7.156	317°47'34"	91°22'47"	13.843	4.168	-281716.830393	-6690.982096
4-16	-1600.022	-20355.658	12.452	226°42'10"	88°54'36"	-3.239	-13.870	65931.976262	22192.305140

倍面積	178.502258
面積	89.2511290
地積	89.25㎡

画地番号：3504-11(4-11)

点名	Xn	Yn	距離	方向角	測角	Xn+1-Xn-1	Yn+1-Yn-1	Yn*(Xn+1-Xn-1)	Xn*(Yn+1-Yn-1)
4-52	-1616.553	-20357.341	9.246	137°16'50"	90°52'03"	-15.312	-2.678	311711.605392	4329.128934
4-21	-1623.346	-20351.069	1.469	52°22'20"	95°05'30"	-5.896	7.436	119989.902824	-12071.200856
4-20	-1622.449	-20349.905	8.105	70°20'18"	197°57'58"	3.624	8.796	-73748.055720	-14271.061404
4-19	-1619.722	-20342.273	4.006	14°10'15"	123°49'57"	6.611	8.613	-134482.766803	-13950.665586
4-18	-1615.838	-20341.292	10.549	317°42'23"	123°32'08"	11.688	-6.118	-237749.020896	9885.696884
4-17	-1608.034	-20348.391	12.356	226°24'47"	88°42'24"	-0.715	-16.049	14549.099565	25807.337666

倍面積	270.764362
面積	135.3821810
地積	135.38㎡

画地番号：3504-12(4-12)

点名	Xn	Yn	距離	方向角	測角	Xn+1-Xn-1	Yn+1-Yn-1	Yn*(Xn+1-Xn-1)	Xn*(Yn+1-Yn-1)
4-24	-1625.778	-20368.611	6.841	136°35'39"	90°11'44"	-14.995	-5.827	305427.321945	9473.408406
4-23	-1630.748	-20363.910	3.017	94°02'49"	137°27'10"	-5.183	7.711	105546.145530	-12574.697828
4-22	-1630.961	-20360.900	12.436	52°14'18"	138°11'29"	7.402	12.841	-150711.381800	-20943.170201
4-21	-1623.346	-20351.069	9.246	317°16'50"	85°02'32"	14.408	3.559	-293218.202152	-5777.488414
4-52	-1616.553	-20357.341	1.092	317°09'55"	179°53'05"	7.593	-7.014	-154573.290213	11338.502742
4-51	-1615.753	-20358.083	14.538	226°23'55"	89°14'00"	-9.225	-11.270	187803.315675	18209.536310

倍面積	273.908985
面積	136.9544925
地積	136.95㎡

画地面積計算書

現場名： 上尾市中平塚区画整理地内

画地番号： 3504-13 (4-13)

参考資料

※記載内容は換地処分当時のものです。 上尾市

点名	Xn	Yn	距離	方向角	測角	X _{n+1} -X _{n-1}	Y _{n+1} -Y _{n-1}	Y _n *(X _{n+1} -X _{n-1})	X _n *(Y _{n+1} -Y _{n-1})
4-25	-1618.618	-20375.395	9.864	136°32'47"	89°50'54"	-16.785	-3.428	342001.005075	5548.622504
4-24	-1625.778	-20368.611	14.538	46°23'55"	89°51'08"	2.865	17.312	-58356.070515	-28145.468736
4-51	-1615.753	-20358.083	2.569	317°17'39"	90°53'44"	11.913	8.785	-242525.842779	-14194.390105
4-58	-1613.865	-20359.826	7.218	317°17'39"	180°00'00"	7.192	-6.638	-146427.868592	10712.835870
4-50	-1608.561	-20364.721	0.632	226°54'45"	89°37'06"	4.872	-5.357	-99216.920712	8617.061277
4-49	-1608.993	-20365.183	14.033	226°41'53"	179°47'08"	-10.057	-10.674	204812.645431	17174.391282

倍面積	286.947908
面積	143.4739540
地積	143.47㎡

画地番号： 3504-14 (4-14)

点名	Xn	Yn	距離	方向角	測角	X _{n+1} -X _{n-1}	Y _{n+1} -Y _{n-1}	Y _n *(X _{n+1} -X _{n-1})	X _n *(Y _{n+1} -Y _{n-1})
4-26	-1611.335	-20382.290	10.029	136°34'03"	89°38'46"	-16.908	-3.398	344623.759320	5475.316330
4-25	-1618.618	-20375.395	14.033	46°41'53"	90°07'50"	2.342	17.107	-47719.175090	-27689.698126
4-49	-1608.993	-20365.183	9.478	316°54'19"	90°12'26"	16.546	3.737	-336962.317918	-6012.806841
4-56	-1602.072	-20371.658	0.496	316°54'19"	180°00'00"	7.283	-6.814	-148366.785214	10916.518608
4-48	-1601.710	-20371.997	14.092	226°55'17"	90°00'58"	-9.263	-10.632	188705.808211	17029.380720

倍面積	281.289309
面積	140.6446545
地積	140.64㎡

画地番号： 3504-15 (4-15)

点名	Xn	Yn	距離	方向角	測角	X _{n+1} -X _{n-1}	Y _{n+1} -Y _{n-1}	Y _n *(X _{n+1} -X _{n-1})	X _n *(Y _{n+1} -Y _{n-1})
4-27	-1604.133	-20389.086	9.902	136°39'32"	89°44'35"	-16.861	-3.532	343780.379046	5665.797756
4-26	-1611.335	-20382.290	14.092	46°55'17"	90°15'45"	2.423	17.089	-49386.288670	-27536.103815
4-48	-1601.710	-20371.997	0.399	317°18'43"	90°23'26"	9.918	10.023	-202049.466246	-16053.939330
4-47	-1601.417	-20372.267	9.505	316°55'46"	179°37'03"	7.236	-6.761	-147413.724012	10827.180337
4-46	-1594.474	-20378.758	14.141	226°54'57"	89°59'11"	-2.716	-16.819	55348.706728	26817.458206

倍面積	279.606846
面積	139.8034230
地積	139.80㎡

画地面積計算書

現場名：上尾市中平塚区画整理地内

画地番号：3504-16 (4-16)

参考資料

※記載内容は換地処分当時のものです。上尾市

点名	Xn	Yn	距離	方向角	測角	X _{n+1} -X _{n-1}	Y _{n+1} -Y _{n-1}	Y _n *(X _{n+1} -X _{n-1})	X _n *(Y _{n+1} -Y _{n-1})
4-28	-1596.594	-20396.217	10.377	136°35'38"	89°41'59"	-17.243	-3.237	351691.969731	5168.174778
4-27	-1604.133	-20389.086	14.141	46°54'57"	90°19'19"	2.120	17.459	-43224.862320	-28006.558047
4-46	-1594.474	-20378.758	1.181	316°58'25"	90°03'28"	10.523	9.522	-214445.670434	-15182.581428
4-45	-1593.610	-20379.564	9.201	316°54'48"	179°56'23"	7.584	-7.091	-154558.613376	11300.288510
4-44	-1586.890	-20385.849	14.200	226°53'39"	89°58'51"	-2.984	-16.653	60831.373416	26426.479170

倍面積	294.197017
面積	147.0985085
地積	147.09㎡

画地番号：3504-17 (4-17)

点名	Xn	Yn	距離	方向角	測角	X _{n+1} -X _{n-1}	Y _{n+1} -Y _{n-1}	Y _n *(X _{n+1} -X _{n-1})	X _n *(Y _{n+1} -Y _{n-1})
4-29	-1589.710	-20402.735	9.480	136°33'51"	89°40'25"	-16.631	-3.895	339317.885785	6191.920450
4-28	-1596.594	-20396.217	14.200	46°53'39"	90°19'48"	2.820	16.886	-57517.331940	-26960.086284
4-44	-1586.890	-20385.849	1.576	317°04'13"	90°10'34"	10.857	9.295	-221329.162593	-14750.142550
4-43	-1585.737	-20386.922	7.905	316°54'50"	179°50'37"	6.927	-6.473	-141220.208694	10264.475601
4-42	-1579.963	-20392.322	14.263	226°53'26"	89°58'36"	-3.973	-15.813	81018.695306	24983.954919

倍面積	269.877864
面積	134.9389320
地積	134.93㎡

画地番号：3504-18 (4-18)

点名	Xn	Yn	距離	方向角	測角	X _{n+1} -X _{n-1}	Y _{n+1} -Y _{n-1}	Y _n *(X _{n+1} -X _{n-1})	X _n *(Y _{n+1} -Y _{n-1})
4-31	-1582.359	-20409.000	7.471	140°27'41"	93°34'21"	-15.207	-5.333	310359.663000	8438.720547
4-30	-1588.120	-20404.244	2.193	136°29'26"	176°01'45"	-7.351	6.265	149991.597644	-9949.571800
4-29	-1589.710	-20402.735	14.263	46°53'26"	90°24'00"	8.157	11.922	-166425.109395	-18952.522620
4-42	-1579.963	-20392.322	2.486	316°56'10"	90°02'44"	11.563	8.715	-235796.419286	-13769.377545
4-41	-1578.147	-20394.020	4.002	316°56'28"	180°00'18"	4.740	-4.430	-96667.654800	6991.191210
4-54	-1575.223	-20396.752	3.162	316°56'28"	180°00'00"	5.234	-4.891	-106756.599968	7704.415693
4-40	-1572.913	-20398.911	13.821	226°53'20"	89°56'52"	-7.136	-12.248	145566.628896	19265.038424

倍面積	272.106091
面積	136.0530455
地積	136.05㎡

画地面積計算書

現場名： 上尾市中平塚区画整理地内

画地番号： 3504-19 (4-19)

参考資料

※記載内容は換地処分当時のものです。 上尾市

点名	Xn	Yn	距離	方向角	測角	Xn+1-Xn-1	Yn+1-Yn-1	Yn*(Xn+1-Xn-1)	Xn*(Yn+1-Yn-1)
4-32	-1574.596	-20415.411	10.067	140° 26' 47"	94° 18' 52"	-16.508	-2.687	337017.604788	4230.939452
4-31	-1582.359	-20409.000	13.821	46° 53' 20"	86° 26' 33"	1.683	16.500	-34348.347000	-26108.923500
4-40	-1572.913	-20398.911	3.452	316° 52' 45"	89° 59' 25"	11.966	7.730	-244093.369026	-12158.617490
4-39	-1570.393	-20401.270	6.787	312° 00' 46"	175° 08' 01"	7.062	-7.402	-144073.768740	11624.048986
4-38	-1565.851	-20406.313	12.620	226° 07' 55"	94° 07' 09"	-4.203	-14.141	85767.733539	22142.698991

倍面積	269.853561
面積	134.9267805
地積	134.92 m ²

画地番号： 3504-20 (4-20)

点名	Xn	Yn	距離	方向角	測角	Xn+1-Xn-1	Yn+1-Yn-1	Yn*(Xn+1-Xn-1)	Xn*(Yn+1-Yn-1)
4-33	-1566.083	-20422.444	11.042	140° 26' 26"	93° 30' 39"	-16.472	-1.482	336398.497568	2320.935006
4-32	-1574.596	-20415.411	12.620	46° 07' 55"	85° 41' 29"	0.232	16.131	-4736.375352	-25399.808076
4-38	-1565.851	-20406.313	3.706	312° 01' 47"	85° 53' 52"	11.227	6.345	-229101.676051	-9935.324595
4-37	-1563.369	-20409.066	7.153	317° 10' 13"	185° 08' 26"	7.727	-7.616	-157700.852982	11906.618304
4-36	-1558.124	-20413.929	11.656	226° 55' 47"	89° 45' 34"	-2.714	-13.378	55403.403306	20844.582872

倍面積	262.996489
面積	131.4982445
地積	131.49 m ²

画地番号： 3504-21 (4-21)

点名	Xn	Yn	距離	方向角	測角	Xn+1-Xn-1	Yn+1-Yn-1	Yn*(Xn+1-Xn-1)	Xn*(Yn+1-Yn-1)
4-54	-1575.223	-20396.752	4.002	136° 56' 28"	90° 00' 59"	-11.037	-5.945	225118.951824	9364.700735
4-41	-1578.147	-20394.020	11.970	46° 55' 29"	89° 59' 01"	5.251	11.476	-107088.999020	-18110.814972
4-9	-1569.972	-20385.276	4.003	315° 38' 23"	88° 42' 54"	11.037	5.945	-224992.291212	-9333.483540
4-53	-1567.110	-20388.075	11.879	226° 55' 29"	91° 17' 06"	-5.251	-11.476	107057.781825	17984.154360

倍面積	95.443417
面積	47.7217085
地積	47.72 m ²

画地面積計算書

現場名： 上尾市中平塚区画整理地内

画地番号： 3504-22(4-22)

参考資料

※記載内容は換地処分当時のものです。 上尾市

点名	Xn	Yn	距離	方向角	測角	X _{n+1} -X _{n-1}	Y _{n+1} -Y _{n-1}	Y _n *(X _{n+1} -X _{n-1})	X _n *(Y _{n+1} -Y _{n-1})
4-47	-1601.417	-20372.267	0.399	137°18'43"	90°21'30"	-9.002	-9.054	183391.147534	14499.229518
4-48	-1601.710	-20371.997	0.496	136°54'19"	179°35'36"	-0.655	0.609	13343.658035	-975.441390
4-56	-1602.072	-20371.658	12.841	46°57'13"	90°02'54"	8.403	9.724	-171183.042174	-15578.548128
4-55	-1593.307	-20362.273	0.898	311°50'18"	84°53'05"	9.364	8.715	-190672.324372	-13885.670505
4-14	-1592.708	-20362.943	12.759	226°57'13"	95°06'55"	-8.110	-9.994	165143.467730	15917.523752

倍面積	22.906753
面積	11.4533765
地積	11.45㎡

画地番号： 3504-23(4-23)

点名	Xn	Yn	距離	方向角	測角	X _{n+1} -X _{n-1}	Y _{n+1} -Y _{n-1}	Y _n *(X _{n+1} -X _{n-1})	X _n *(Y _{n+1} -Y _{n-1})
4-58	-1613.865	-20359.826	2.569	137°17'39"	90°52'52"	-10.431	-7.232	212373.345006	11671.471680
4-51	-1615.753	-20358.083	1.092	137°09'55"	179°52'16"	-2.688	2.485	54722.527104	-4015.146205
4-52	-1616.553	-20357.341	12.356	46°24'47"	89°14'52"	7.719	9.692	-157138.315179	-15667.631676
4-17	-1608.034	-20348.391	3.661	317°47'34"	91°22'47"	11.231	6.490	-228532.779321	-10436.140660
4-57	-1605.322	-20350.851	12.390	226°24'47"	88°37'13"	-5.831	-11.435	118665.812181	18356.857070

倍面積	90.589791
面積	45.2948955
地積	45.29㎡