
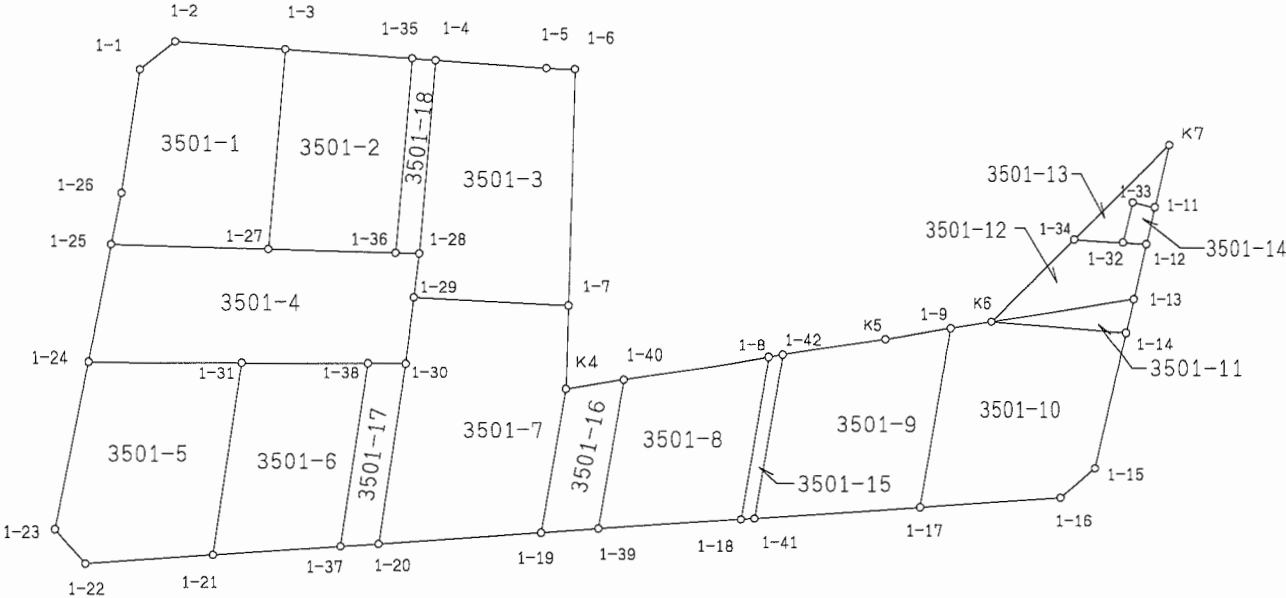


上尾市中平塚土地区画整理事業出来形確認測量 画地原子図

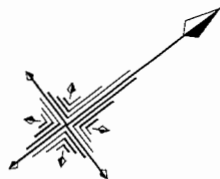

参考資料

※記載内容は換地処分当時のものです。 上尾市

画地面積計算書

現場名： 上尾市中平塚区画整理地内

画地番号： 3501-1(1-1)

参考資料

※記載内容は換地処分当時のものです。 上尾市

点名	Xn	Yn	距離	方向角	測角	Xn+1-Xn-1	Yn+1-Yn-1	Yn*(Xn+1-Xn-1)	Xn*(Yn+1-Yn-1)
1-1	-1618.068	-20473.395	8.236	136°01'51"	137°11'36"	-8.910	5.778	182417.949450	-9349.196904
1-26	-1623.995	-20467.678	3.461	138°37'34"	182°35'43"	-8.524	8.005	174466.487272	-13000.079975
1-25	-1626.592	-20465.390	10.390	39°08'18"	80°30'44"	5.461	8.846	-111761.494790	-14388.832832
1-27	-1618.534	-20458.832	13.222	312°19'18"	93°11'00"	16.960	-3.218	-346981.790720	5208.442412
1-3	-1609.632	-20468.608	7.297	221°38'26"	89°19'08"	3.449	-14.624	-70596.228992	23539.258368
1-2	-1615.085	-20473.456	2.984	178°50'15"	137°11'49"	-8.436	-4.787	172714.074816	7731.411895

倍面積	258.997036
面積	129.4985180
地積	129.49㎡

画地番号： 3501-2(1-2)

点名	Xn	Yn	距離	方向角	測角	Xn+1-Xn-1	Yn+1-Yn-1	Yn*(Xn+1-Xn-1)	Xn*(Yn+1-Yn-1)
1-3	-1609.632	-20468.608	13.222	132°19'18"	90°40'52"	-15.183	4.192	310774.875264	-6747.577344
1-27	-1618.534	-20458.832	8.403	39°09'35"	86°50'17"	-2.386	15.083	48814.773152	-24412.348322
1-36	-1612.018	-20453.525	12.858	312°22'43"	93°13'08"	15.183	-4.192	-310545.870075	6757.579456
1-35	-1603.351	-20463.024	8.404	221°38'26"	89°15'43"	2.386	-15.083	-48824.775264	24183.343133

倍面積	219.003077
面積	109.5015385
地積	109.50㎡

画地番号： 3501-3(1-3)

点名	Xn	Yn	距離	方向角	測角	Xn+1-Xn-1	Yn+1-Yn-1	Yn*(Xn+1-Xn-1)	Xn*(Yn+1-Yn-1)
1-4	-1602.185	-20461.987	12.790	132°22'43"	90°44'17"	-14.095	4.582	288411.706765	-7341.211670
1-28	-1610.807	-20452.539	2.917	134°35'56"	182°13'13"	-10.670	11.525	218228.591130	-18564.550675
1-29	-1612.855	-20450.462	10.232	40°24'09"	85°48'13"	5.744	8.709	-117467.453728	-14046.354195
1-7	-1605.063	-20443.830	15.565	309°05'43"	88°41'34"	17.607	-5.448	-359954.514810	8744.383224
1-6	-1595.248	-20455.910	1.900	219°35'38"	90°29'55"	8.351	-13.291	-170827.304410	21202.441168
1-5	-1596.712	-20457.121	7.323	221°38'26"	182°02'48"	-6.937	-6.077	141911.048377	9703.218824

倍面積	302.073324
面積	151.0366620
地積	151.03㎡

画地面積計算書

現場名： 上尾市中平塚区画整理地内

画地番号： 3501-4 (1-4)

参考資料

※記載内容は換地処分当時のものです。 上尾市

点名	Xn	Yn	距離	方向角	測角	X _{n+1} -X _{n-1}	Y _{n+1} -Y _{n-1}	Y _n *(X _{n+1} -X _{n-1})	X _n *(Y _{n+1} -Y _{n-1})
1-25	-1626.592	-20465.390	7.885	138°31'46"	99°23'28"	-13.966	-1.337	285819.636740	2174.753504
1-24	-1632.500	-20460.169	10.128	37°46'33"	79°14'47"	2.097	11.425	-42904.974393	-18651.312500
1-31	-1624.495	-20453.965	8.332	37°46'12"	179°59'39"	14.591	11.308	-298443.803315	-18369.789460
1-38	-1617.909	-20448.861	2.495	37°46'12"	180°00'00"	8.558	6.632	-175001.352438	-10729.972488
1-30	-1615.937	-20447.333	4.391	314°33'59"	96°47'47"	5.054	-1.601	-103340.820982	2587.115137
1-29	-1612.855	-20450.462	2.917	314°35'56"	180°01'57"	5.130	-5.206	-104910.870060	8396.523130
1-28	-1610.807	-20452.539	1.562	219°09'35"	84°33'39"	0.837	-3.063	-17118.775143	4933.901841
1-36	-1612.018	-20453.525	8.403	219°09'35"	180°00'00"	-7.727	-6.293	158044.387675	10144.429274
1-27	-1618.534	-20458.832	10.390	219°08'18"	179°58'43"	-14.574	-11.865	298167.017568	19203.905910

倍面積	310.445652
面積	155.2228260
地積	155.22㎡

画地番号： 3501-5 (1-5)

点名	Xn	Yn	距離	方向角	測角	X _{n+1} -X _{n-1}	Y _{n+1} -Y _{n-1}	Y _n *(X _{n+1} -X _{n-1})	X _n *(Y _{n+1} -Y _{n-1})
1-24	-1632.500	-20460.169	11.343	138°35'05"	100°48'32"	-16.512	1.300	337838.310528	-2122.250000
1-23	-1641.007	-20452.665	3.027	85°55'32"	127°20'27"	-8.292	10.523	169593.498180	-17268.316661
1-22	-1640.792	-20449.646	8.440	33°31'49"	127°36'17"	7.251	7.682	-148280.383146	-12604.564144
1-21	-1633.756	-20444.983	12.901	315°52'41"	102°20'52"	16.297	-4.319	-333191.887951	7056.192164
1-31	-1624.495	-20453.965	10.128	217°46'33"	81°53'52"	1.256	-15.186	-25690.180040	24669.581070

倍面積	269.357571
面積	134.6787855
地積	134.67㎡

画地番号： 3501-6 (1-6)

点名	Xn	Yn	距離	方向角	測角	X _{n+1} -X _{n-1}	Y _{n+1} -Y _{n-1}	Y _n *(X _{n+1} -X _{n-1})	X _n *(Y _{n+1} -Y _{n-1})
1-31	-1624.495	-20453.965	12.901	135°52'41"	98°06'29"	-15.847	3.878	324133.983355	-6299.791610
1-21	-1633.756	-20444.983	8.444	33°35'32"	77°42'51"	-2.228	13.653	45551.422124	-22305.670668
1-37	-1626.723	-20440.312	12.279	315°52'20"	102°16'48"	15.847	-3.878	-323917.624264	6308.431794
1-38	-1617.909	-20448.861	8.332	217°46'12"	81°53'52"	2.228	-13.653	-45560.062308	22089.311577

倍面積	207.718907
面積	103.8594535
地積	103.85㎡

画地面積計算書

現場名：上尾市中平塚区画整理地内

画地番号：3501-7(1-7)

参考資料

※記載内容は換地処分当時のものです。上尾市

点名	Xn	Yn	距離	方向角	測角	Xn+1-Xn-1	Yn+1-Yn-1	Yn*(Xn+1-Xn-1)	Xn*(Yn+1-Yn-1)
1-29	-1612.855	-20450.462	4.391	134°33'59"	94°09'50"	-10.874	-3.503	222378.323788	5649.831065
1-30	-1615.937	-20447.333	12.093	135°52'20"	181°18'21"	-11.762	11.549	240501.530746	-18662.456413
1-20	-1624.617	-20438.913	10.764	33°35'52"	77°43'32"	0.286	14.376	-5845.529118	-23355.493992
1-19	-1615.651	-20432.957	9.672	317°08'49"	103°32'57"	16.057	-0.622	-328091.990549	1004.934922
K4	-1608.560	-20439.535	5.539	309°08'56"	172°00'07"	10.588	-10.873	-216413.796580	17489.872880
1-7	-1605.063	-20443.830	10.232	220°24'09"	91°15'13"	-4.295	-10.927	87806.249850	17538.523401

倍面積	334.788137
面積	167.3940685
地積	167.39㎡

画地番号：3501-8(1-8)

点名	Xn	Yn	距離	方向角	測角	Xn+1-Xn-1	Yn+1-Yn-1	Yn*(Xn+1-Xn-1)	Xn*(Yn+1-Yn-1)
1-40	-1605.156	-20437.678	10.020	137°08'49"	108°32'09"	-15.848	2.177	323896.320944	-3494.424612
1-39	-1612.502	-20430.863	9.444	33°37'04"	76°28'15"	0.519	12.044	-10603.617897	-19420.974088
1-18	-1604.637	-20425.634	10.889	317°08'49"	103°31'45"	15.848	-2.177	-323705.447632	3493.294749
1-8	-1596.654	-20433.040	9.684	208°36'40"	71°27'51"	-0.519	-12.044	10604.747760	19230.100776

倍面積	192.003175
面積	96.0015875
地積	96.00㎡

画地番号：3501-9(1-9)

点名	Xn	Yn	距離	方向角	測角	Xn+1-Xn-1	Yn+1-Yn-1	Yn*(Xn+1-Xn-1)	Xn*(Yn+1-Yn-1)
1-42	-1595.838	-20432.599	10.977	137°08'49"	108°46'29"	-14.087	4.203	287834.022113	-6707.307114
1-41	-1603.885	-20425.134	10.951	33°37'33"	76°28'44"	1.072	13.529	-21895.743648	-21698.960165
1-17	-1594.766	-20419.070	12.032	317°05'03"	103°27'30"	17.930	-2.128	-366113.925100	3393.662048
1-9	-1585.955	-20427.262	4.368	208°21'52"	71°16'49"	4.968	-10.267	-101482.637616	16282.999985
K5	-1589.798	-20429.337	6.865	208°22'20"	180°00'28"	-9.883	-5.337	201903.137571	8484.751926

倍面積	244.853320
面積	122.4266600
地積	122.42㎡

画地面積計算書

現場名： 上尾市中平塚区画整理地内

画地番号： 3501-10 (1-10)

参考資料

※記載内容は換地処分当時のものです。 上尾市

点名	Xn	Yn	距離	方向角	測角	Xn+1-Xn-1	Yn+1-Yn-1	Yn*(Xn+1-Xn-1)	Xn*(Yn+1-Yn-1)
1-9	-1585.955	-20427.262	12.032	137°05'03"	108°37'30"	-11.215	6.889	229091.743330	-10925.643995
1-17	-1594.766	-20419.070	9.293	33°38'58"	76°33'55"	-1.076	13.342	21970.919320	-21277.367972
1-16	-1587.031	-20413.920	3.002	356°44'57"	143°05'59"	10.732	4.979	-219082.189440	-7901.827349
1-15	-1584.034	-20414.091	9.217	320°19'57"	143°35'00"	10.092	-6.054	-206019.006372	9589.741836
1-14	-1576.939	-20419.974	8.918	222°09'12"	81°49'15"	0.483	-11.868	-9862.847442	18715.112052
K6	-1583.551	-20425.959	2.734	208°27'33"	166°18'21"	-9.016	-7.288	184160.446344	11540.919688

倍面積	259.065740
面積	129.5328700
地積	129.53㎡

画地番号： 3501-11 (1-11)

点名	Xn	Yn	距離	方向角	測角	Xn+1-Xn-1	Yn+1-Yn-1	Yn*(Xn+1-Xn-1)	Xn*(Yn+1-Yn-1)
K6	-1583.551	-20425.959	8.918	42°09'12"	13°45'09"	-1.769	1.454	36133.521471	-2302.483154
1-14	-1576.939	-20419.974	2.290	320°35'04"	98°25'52"	8.381	4.531	-171139.802094	-7145.110609
1-13	-1575.170	-20421.428	9.527	208°24'03"	67°48'59"	-6.612	-5.985	135026.481936	9427.392450

倍面積	20.201313
面積	10.1006565
地積	10.10㎡

画地番号： 3501-12 (1-12)

点名	Xn	Yn	距離	方向角	測角	Xn+1-Xn-1	Yn+1-Yn-1	Yn*(Xn+1-Xn-1)	Xn*(Yn+1-Yn-1)
1-34	-1575.909	-20426.945	7.705	172°39'13"	131°38'46"	-10.081	-1.135	205924.032545	1788.656715
K6	-1583.551	-20425.959	9.527	28°24'03"	35°44'50"	0.739	5.517	-15094.783701	-8736.450867
1-13	-1575.170	-20421.428	3.713	320°17'21"	111°53'18"	11.237	2.159	-229475.586436	-3400.792030
1-12	-1572.314	-20423.800	1.544	221°31'33"	81°14'12"	1.700	-3.396	-34720.460000	5339.578344
1-32	-1573.470	-20424.824	3.232	221°00'27"	179°28'54"	-3.595	-3.145	73427.242280	4948.563150

倍面積	60.444688
面積	30.2223440
地積	30.22㎡

画地面積計算書

現場名：上尾市中平塚区画整理地内

画地番号：3501-13(1-13)

参考資料

※記載内容は換地処分当時のものです。上尾市

点名	Xn	Yn	距離	方向角	測角	Xn+1-Xn-1	Yn+1-Yn-1	Yn*(Xn+1-Xn-1)	Xn*(Yn+1-Yn-1)
K7	-1567.140	-20428.075	8.841	172°39'13"	32°09'37"	-5.519	-1.550	112742.545925	2429.067000
1-34	-1575.909	-20426.945	3.232	41°00'27"	48°21'14"	-6.330	3.251	129302.561850	-5123.280159
1-32	-1573.470	-20424.824	2.724	320°44'22"	99°43'55"	4.549	0.397	-92912.524376	-624.667590
1-33	-1571.360	-20426.548	1.506	49°54'55"	269°10'33"	3.080	-0.571	-62913.767840	897.246560
1-11	-1570.390	-20425.395	4.213	320°29'36"	90°34'41"	4.220	-1.527	-86195.166900	2397.985530

倍面積	23.648659
面積	11.8243295
地積	11.82㎡

画地番号：3501-14(1-14)

点名	Xn	Yn	距離	方向角	測角	Xn+1-Xn-1	Yn+1-Yn-1	Yn*(Xn+1-Xn-1)	Xn*(Yn+1-Yn-1)
1-11	-1570.390	-20425.395	1.506	229°54'55"	89°34'56"	0.954	-2.748	-19485.826830	4315.431720
1-33	-1571.360	-20426.548	2.724	140°44'22"	90°49'27"	-3.080	0.571	62913.767840	-897.246560
1-32	-1573.470	-20424.824	1.544	41°31'33"	80°47'11"	-0.954	2.748	19485.282096	-4323.895560
1-12	-1572.314	-20423.800	2.499	320°19'59"	98°48'26"	3.080	-0.571	-62905.304000	897.791294

倍面積	7.919106
面積	3.9595530
地積	3.95㎡

画地番号：3501-15(1-15)

点名	Xn	Yn	距離	方向角	測角	Xn+1-Xn-1	Yn+1-Yn-1	Yn*(Xn+1-Xn-1)	Xn*(Yn+1-Yn-1)
1-8	-1596.654	-20433.040	10.889	137°08'49"	108°46'29"	-8.799	6.965	179790.318960	-11120.695110
1-18	-1604.637	-20425.634	0.903	33°37'33"	76°28'44"	-7.231	7.906	147697.759454	-12686.260122
1-41	-1603.885	-20425.134	10.977	317°08'49"	103°31'16"	8.799	-6.965	-179720.754066	11171.059025
1-42	-1595.838	-20432.599	0.928	208°22'20"	71°13'31"	7.231	-7.906	-147748.123369	12616.695228

倍面積	19.200979
面積	9.6004895
地積	9.60㎡

画地面積計算書

現場名：上尾市中平塚区画整理地内

画地番号：3501-16(1-16)

参考資料

※記載内容は換地処分当時のものです。上尾市

点名	Xn	Yn	距離	方向角	測角	Xn+1-Xn-1	Yn+1-Yn-1	Yn*(Xn+1-Xn-1)	Xn*(Yn+1-Yn-1)
K4	-1608.560	-20439.535	9.672	137°08'49"	108°32'09"	-10.495	4.721	214512.919825	-7594.011760
1-19	-1615.651	-20432.957	3.782	33°37'04"	76°28'15"	-3.942	8.672	80546.716494	-14010.925472
1-39	-1612.502	-20430.863	10.020	317°08'49"	103°31'45"	10.495	-4.721	-214421.907185	7612.621942
1-40	-1605.156	-20437.678	3.878	208°36'40"	71°27'51"	3.942	-8.672	-80565.326676	13919.912832

倍面積	72.402458
面積	36.2012290
地積	36.20㎡

画地番号：3501-17(1-17)

点名	Xn	Yn	距離	方向角	測角	Xn+1-Xn-1	Yn+1-Yn-1	Yn*(Xn+1-Xn-1)	Xn*(Yn+1-Yn-1)
1-38	-1617.909	-20448.861	12.279	135°52'20"	98°06'08"	-10.786	7.021	220561.414746	-11359.339089
1-37	-1626.723	-20440.312	2.528	33°35'32"	77°43'12"	-6.708	9.948	137113.612896	-16182.640404
1-20	-1624.617	-20438.913	12.093	315°52'20"	102°16'48"	10.786	-7.021	-220454.115618	11406.435957
1-30	-1615.937	-20447.333	2.495	217°46'12"	81°53'52"	6.708	-9.948	-137160.709764	16075.341276

倍面積	60.202260
面積	30.1011300
地積	30.10㎡

画地番号：3501-18(1-18)

点名	Xn	Yn	距離	方向角	測角	Xn+1-Xn-1	Yn+1-Yn-1	Yn*(Xn+1-Xn-1)	Xn*(Yn+1-Yn-1)
1-35	-1603.351	-20463.024	12.858	132°22'43"	90°44'17"	-9.833	8.462	201212.914992	-13567.556162
1-36	-1612.018	-20453.525	1.562	39°09'35"	86°46'52"	-7.456	10.485	152501.482400	-16902.008730
1-28	-1610.807	-20452.539	12.790	312°22'43"	93°13'08"	9.833	-8.462	-201109.815987	13630.648834
1-4	-1602.185	-20461.987	1.560	221°38'26"	89°15'43"	7.456	-10.485	-152564.575072	16798.909725

倍面積	40.006333
面積	20.0031665
地積	20.00㎡